

KANSAS

Map No. \_\_\_\_\_ Sec. 32 Twp. 14 R. 2W

Well No. 1 Norton

Page etal. \_\_\_\_\_ Company \_\_\_\_\_

FIRST REPORT Contractor \_\_\_\_\_

SW NE

SECTION PLAT

		0	

Ft. from N. Line

330 Ft. from S. Line

Ft. from E. Line

330 Ft. from W. Line

Saline County

Location X

RECORD

Cased \_\_\_\_\_ in., \_\_\_\_\_ ft.

Sand \_\_\_\_\_

Gas \_\_\_\_\_

Oil \_\_\_\_\_

Total Depth \_\_\_\_\_

PRODUCTION

1st 24 hrs. Nat. \_\_\_\_\_

1st 24 hrs. after shot \_\_\_\_\_

Gas \_\_\_\_\_ Cu. Ft.

Dry Hole \_\_\_\_\_

Abandoned \_\_\_\_\_

Date

MAR 12 1947 19 S. J. LEWIS Scout

Kansas

Map No. 51 Sec. 32 Twp. 14 R. 2W

Well No. 1 Norton

Page etal. \_\_\_\_\_ Company \_\_\_\_\_

COMPLETE Contractor \_\_\_\_\_

SW NE

SECTION PLAT

		0	

Ft. from N. Line

330 Ft. from S. Line

Ft. from E. Line

330 Ft. from W. Line

Saline County

Location

RECORD

Cased \_\_\_\_\_ in., \_\_\_\_\_ ft.

Sand \_\_\_\_\_

Gas \_\_\_\_\_

Oil \_\_\_\_\_

Total Depth 3296

PRODUCTION

1st 24 hrs. Nat. \_\_\_\_\_

1st 24 hrs. after shot \_\_\_\_\_

Gas \_\_\_\_\_ Cu. Ft.

Dry Hole \_\_\_\_\_

Abandoned \_\_\_\_\_

Date

AUG 20 1947 19 S. J. LEWIS Scout

KANSAS

Saline



Sec. 32 Twp. 14 R. 2-W

Well No. #1 Norton Farm


Page etal Company  
Salina Pool

Ft. from N. Line

330 Ft. from S. Line

Ft. from E. Line

330 Ft. from W. Line

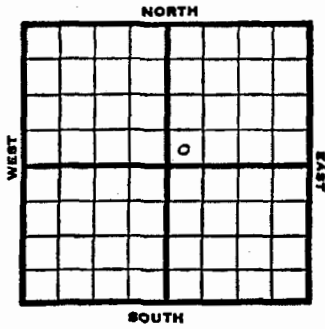

SW NE

1947	Elev. 1314'	REPORT
3/12		Location
3/18		"
3/25		"
4/2		"
4/9		"
4/15		"
4/23		"
4/29		"
5/7		"
5/13		"
5/20		"
5/27		Spud.
6/3		"
6/10		SD
6/17		10" @ 250 WOC
6/24		Drilg 2140'

OVER

1947

7/1 Mississippi 2655'  
TD 3296  
Viola 3284'  
5" @ 3285'

7/8 "

7-16 TD 3296

7/22 "

7/29 "

8/6 1000 Acid.  
1000 Oil / 200' W in 8 hrs.

8/13 "

8/20 Viola 3284'  
5" @ 3285'  
Acid 1000  
Pump 50 Pot.  
gr. 36  
T.D. 3296'  
Completed

COMPLETED

Section 32 Township 14 Range 2-W

Well No. #1 Norton

Company Page et al

