

Map No. _____ Sec. 32 Twp. 14 R. 2W
Well No. 2 Norton "B"

L. V. Jackson


Company

FIRST REPORT

Contractor

SW SE NE

SECTION PLAT

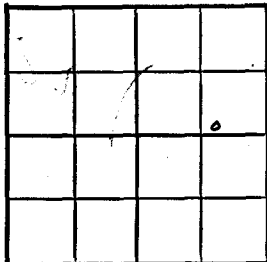

Ft. from N. Line

330 Ft. from S. Line990 Ft. from E. Line

Ft. from W. Line

Saline County

Location X

Rig up

Drilling and Remarks:

RECORD

Cased _____ in., _____ ft.

Sand _____

Gas _____

Oil _____

Total Depth _____

PRODUCTION

1st 24 hrs. Nat. _____

1st 24 hrs. after shot _____

Gas _____ Cu. Ft.

Dry Hole _____

Abandoned _____

Date

AUG 27 1947

19

S. J. LEWIS

Scout

Map No. 51 Sec. 32 Twp. 14 R. 2W
Well No. 2 Norton "B"

L. V. Jackson


Company

COMPLETE

Contractor

SW SE NE

SECTION PLAT

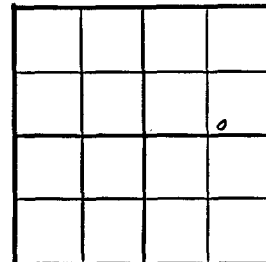

Ft. from N. Line

330 Ft. from S. Line990 Ft. from E. Line

Ft. from W. Line

Saline County

Location _____

Rig up

Drilling and Remarks:

*Wota 8276**5" @ 8277**4000 acid**Pump 1460 oil +**25% WPD**8728*

RECORD

Cased _____ in., _____ ft.

Sand _____

Gas _____

Oil _____

Total Depth 8277

PRODUCTION

1st 24 hrs. Nat. _____

1st 24 hrs. after shot _____

Gas _____ Cu. Ft.

Dry Hole _____

Abandoned _____

Date

OCT 22 1947

19

S. J. LEWIS

Scout

KANSAS Saline

Sec. 32 Twp. 14 R. 2W

Well No. #2 Norton "B" Farm

L. V. Jackson Company

Salina


Ft. from N. Line

330 Ft. from S. Line

990 Ft. from E. Line

Ft. from W. Line

SW SE NE

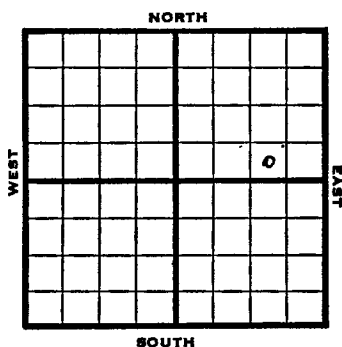

1947 Elev. 1308' REPORT

8/27 Location

9/3 8' @ 232
Drlg. 725

9/10 Drlg. 3162'

9/17 Viola 3276'
TD 3279'
5" @ 3277'
RUST

9/24 2000 acid
Swabb 5 bbls. oil PH

10/1 2000 acid no increase.

10/8 "

10/15 "

10/22 Viola 3276'
5" @ 3277'
4000 Acid
Pump 146 oil & 25% W Pot
Gr. 37°
Total Depth 3279'

COMPLETED

Saline

KANSAS

Section 32 Township 14 Range 2W

Well No. 2 Norton "B"

Company L. V. Jackson

