

KANSAS Kansas Pool Name Wildcat

Map No. 51 Sec. 32 Twp. 14 R. 2W

Well No. 1 Hagg

Lucian Walker Company

FIRST REPORT Contractor

NW SE SW

SECTION PLAT

|  |  |  |  |
|--|--|--|--|
|  |  |  |  |
|  |  |  |  |
|  |  |  |  |
|  |  |  |  |
|  |  |  |  |
|  |  |  |  |
|  |  |  |  |
|  |  |  |  |

\_\_\_\_\_ Ft. from N. Line

990 Ft. from S. Line

990 Ft. from E. Line

\_\_\_\_\_ Ft. from W. Line

Saline County

Location \_\_\_\_\_

Rig up \_\_\_\_\_

Drilling and Remarks:

10" @ 285 WOC

RECORD

Cased \_\_\_\_\_ in., \_\_\_\_\_ ft.

Sand \_\_\_\_\_

Gas \_\_\_\_\_

Oil \_\_\_\_\_

Total Depth \_\_\_\_\_

PRODUCTION

1st 24 hrs. Nat. \_\_\_\_\_

1st 24 hrs. after shot \_\_\_\_\_

Gas \_\_\_\_\_ Cu. Ft.

Dry Hole \_\_\_\_\_

Abandoned \_\_\_\_\_

Date

APR 3 1946 19 S. J. LEWIS Scout

KANSAS Kansas Pool Name Wildcat

Map No. 51 Sec. 32 Twp. 14 R. 2W

Well No. 1 Hagg

W. J. Page et al. Company

CORRECTION Contractor

NW SE SW

SECTION PLAT

|  |  |  |  |
|--|--|--|--|
|  |  |  |  |
|  |  |  |  |
|  |  |  |  |
|  |  |  |  |
|  |  |  |  |
|  |  |  |  |
|  |  |  |  |
|  |  |  |  |

\_\_\_\_\_ Ft. from N. Line

990 Ft. from S. Line

990 Ft. from E. Line

\_\_\_\_\_ Ft. from W. Line

Saline County

Location \_\_\_\_\_

Rig up \_\_\_\_\_

Drilling and Remarks:

Reported as  
Lucian Walker

RECORD

Cased \_\_\_\_\_ in., \_\_\_\_\_ ft.

Sand \_\_\_\_\_

Gas \_\_\_\_\_

Oil \_\_\_\_\_

Total Depth \_\_\_\_\_

PRODUCTION

1st 24 hrs. Nat. \_\_\_\_\_

1st 24 hrs. after shot \_\_\_\_\_

Gas \_\_\_\_\_ Cu. Ft.

Dry Hole \_\_\_\_\_

Abandoned \_\_\_\_\_

Date

APR 10 1946 19 S. J. LEWIS Scout

KANSAS Kansas Pool Name Wildcat

Map No. 5/ Sec. 32 Twp. 14 R. 2W

Well No. 1 Hagg

W. J. Page etal. Company

CORRECTION Contractor

NW SW SE


SECTION PLAT

         Ft. from N. Line

990 Ft. from S. Line

         Ft. from E. Line

330 Ft. from W. Line

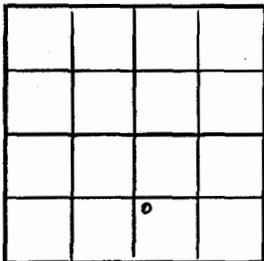

Saline County

Location \_\_\_\_\_

Rig up \_\_\_\_\_

Drilling and Remarks:

Reported

NW SE SW

RECORD

Cased \_\_\_\_\_ in, \_\_\_\_\_ ft.

Sand \_\_\_\_\_

Gas \_\_\_\_\_

Oil \_\_\_\_\_

Total Depth \_\_\_\_\_

PRODUCTION

1st 24 hrs. Nat. \_\_\_\_\_

1st 24 hrs. after shot \_\_\_\_\_

Gas \_\_\_\_\_ Cu. Ft.

Dry Hole \_\_\_\_\_

Abandoned \_\_\_\_\_

Date

APR 24 1946 19 S. J. LEWIS Scout

KANSAS Kansas Pool Name Wildcat

Map No. 5/ Sec. 32 Twp. 14 R. 2W

Well No. 1 Hagg

W. J. Page, etal Company

COMPLETED Contractor

NW SW SE


E11272  
SECTION PLAT

         Ft. from N. Line

990 Ft. from S. Line

         Ft. from E. Line

330 Ft. from W. Line

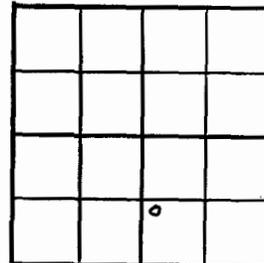

Saline County

Location \_\_\_\_\_

Rig up \_\_\_\_\_

Drilling and Remarks:

Notes 32+6

7" @ 32+6

1000 acid

Pump 9' oil + 22N

PJT

200-62

RECORD

Cased \_\_\_\_\_ in, \_\_\_\_\_ ft.

Sand \_\_\_\_\_

Gas \_\_\_\_\_

Oil \_\_\_\_\_

Total Depth 8402

PRODUCTION

1st 24 hrs. Nat. \_\_\_\_\_

1st 24 hrs. after shot \_\_\_\_\_

Gas \_\_\_\_\_ Cu. Ft.

Dry Hole \_\_\_\_\_

Abandoned \_\_\_\_\_

Date

JUN 5 1946 19 S. J. LEWIS Scout

KANSAS

Saline County

Sec. 32 Twp. 14 R. 2W

Well No. #1 Hagg Farm

~~Lucian Walker~~ W.J. Page et al Company

Wildcat


Ft. from N. Line

990 Ft. from S. Line

~~990~~ Ft. from E. Line

330 Ft. from W. Line

NW ~~SE~~ SW SW SE

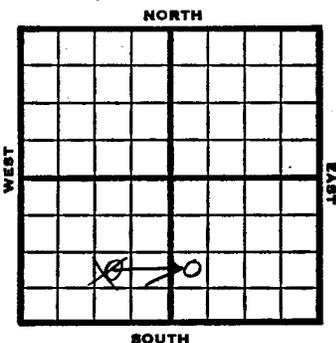

| 1946 |  | REPORT |
|------|--|--------|
|      | Elev. 1272   |        |
| 4/3  | 10" @ 285' WOC   |        |
| 4/10 | Drlg 2838  |        |
| 4/16 | Miss 2651<br>Hunt on 3033<br>Viola 3246<br>TD 3252 Run csg.                                    |        |
| 4/23 | 7" @ 3246<br>Bail 5 oil<br>1 wtr in 10 hrs   |        |
| 5/1  | 1000 acid Pump 150 fluid<br>30% W in 24 hrs  |        |
| 5/7  | " " "  |        |
| 5/14 | " " "  |        |
| 5/21 | " " "  |        |
| 5/29 | " " "  |        |
| 6/5  | Viola 3246<br>7" @ 3246<br>1000 acid.<br>TD 3252'<br>Pump 91 oil plus 22 W. Pot.<br>Grav. 35.0 |        |

COMPLETED

KANSAS Saline county

Section 32 Township 14 Range 2W

Well No. #1, Hagg

W.J. Page et al  
Company ~~Lucian Walker~~

