

KANSAS

Map No. 37 Sec. 33 Twp. 14 R. 2WWell No. 1 Craig

E. S. Adkins Company

FIRST REPORT

SW NW

SECTION PLAT

o			

Ft. from N. Line

330 Ft. from S. Line

Ft. from E. Line

330 Ft. from W. Line

Wildcat

Location

Rig up

Drilling and Remarks:

Drlg. 219

RECORD

Cased in, ft.

Sand

Gas

Oil

Total Depth

PRODUCTION

1st 24 hrs. Nat.

1st 24 hrs. after shot

Gas Cu. Ft.

Dry Hole

Abandoned

Date

JAN 12 1944

19

S. J. LEWIS Scout

KANSAS

Map No. 33 Sec. 33 Twp. 14 R. 2WWell No. 1 Craig

E. S. Adkins Company

ABANDONED

Contractor

SW NW

SECTION PLAT

o			

Ft. from N. Line

330 Ft. from S. Line

Ft. from E. Line

330 Ft. from W. Line

Wildcat

Location

Rig up

Drilling and Remarks:

Lans 2042

BHC 2342

Hair 2681

Amel 2943

Vista 3301

Snap 3389

RECORD

Cased in, ft.

Sand

Gas

Oil

Total Depth 3448

PRODUCTION

1st 24 hrs. Nat.

1st 24 hrs. after shot

Gas Cu. Ft.

Dry Hole

Abandoned

Date

FEB 2 1944

19

S. J. LEWIS Scout

Saline

Sec. 33 Twp. 14 R. 2-W

Well No. #1 Craig Farm

E. S. Adkins Company


 Ft. from N. Line

330 Ft. from S. Line

 Ft. from E. Line

330 Ft. from W. Line

Elev. 1296

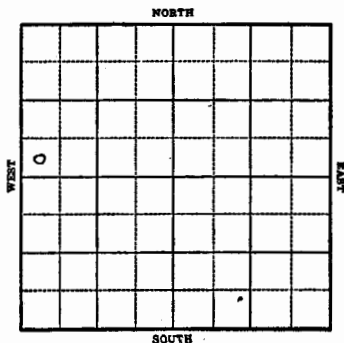

1944 REPORT

1-12 Drlg. 219'

1/19 10" @ 248
Drlg. 2300'

1/26 Miss. 27330
Drlg. 3000

2/2 Lans 2047
BKC 2342
Miss 2681
Kind 2943
Viola 3301
imp 3389
TD 3448

ABANDONED

Saline

Section 33 Township 14 Range 2-W

Well No. #1 Craig

Company E. S. Adkins

