


Section 2 Township 14 Range 15-W

Well No. #2 Sullivan

Company J Lindas

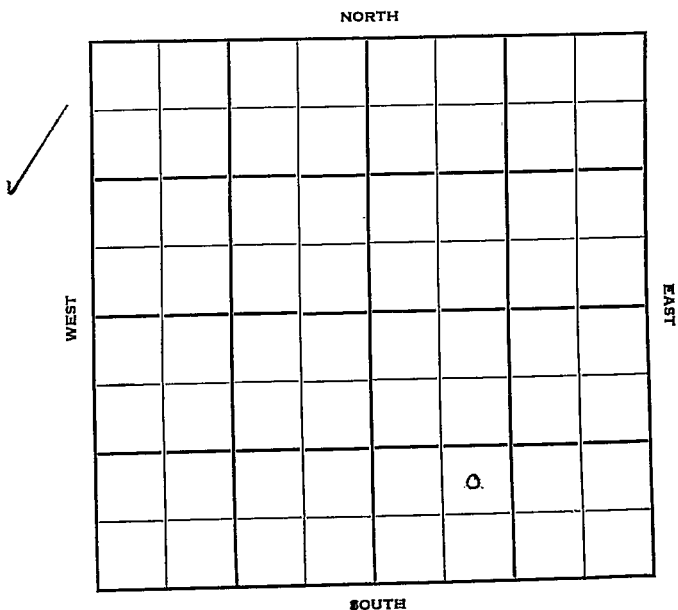

L

KANSAS

Sec. 2 Twp. 14 R. 15-W

Well No. #2 Sullivan Farm

J. Lindas Company

Contractor

Big Creek


Ft. from N. Line

990 Ft. from S. Line

Ft. from E. Line

990 Ft. from W. Line

NE SW SE

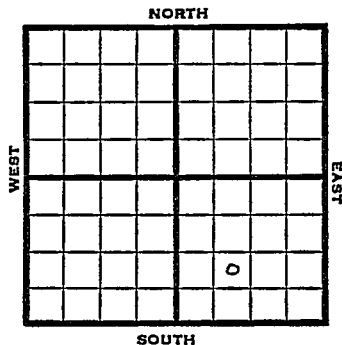

1950 Elev 1882 REPORT

6/7 Spud 6-5-50
8" @ 157'
W.O.C.

6/28 8" @ 157
Anhy 910-40 Lans 3048
gorham sand 3302-04
TD 3310
1000 acid
S/4 boph
Arb 3305
Comp 50 bopd
Completed
COMPLETED

Map No. _____ Sec. 2 Twp. 14 R. 15W

Well No. 2 Sullivan

J. Lindas

Company

Contractor

NE SW SE

SECTION PLAT

FIRST REPORT			
		0	

_____ Ft. from N. Line

990 Ft. from S. Line

_____ Ft. from E. Line

990 Ft. from W. Line

Russell

Location _____

Rig up _____

Drilling and Remarks:

Spud 6-5-50

8" @ 157'

W. O. C.

RECORD

Cased _____ in., _____ ft.

Sand _____

Gas _____

Oil _____

Total Depth _____

PRODUCTION

1st 24 hrs. Nat. _____

1st 24 hrs. after shot _____

Gas _____ Cu. Ft.

Dry Hole _____

Abandoned _____


Date

JUN 7 1950 19

J E TYRA Scout

Map No. _____ Sec. 2 Twp. 14 R. 15WWell No. 2 Sullivan_____
John Lindas_____
Company_____
Contractor

NE SW SE

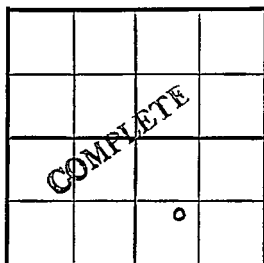El. 1882
SECTION PLAT_____
Ft. from N. Line990 Ft. from S. Line_____
Ft. from E. Line990 Ft. from W. Line

Russell County

Location _____

Rig up _____

Drilling and Remarks:

8" C 157

Anhy 910-40

Lans. 3048

gorham sand

3302-04

TD 3310

1000 acid

RECORD

Cased _____ in., _____ ft.

Sand _____

Gas _____

Oil _____

Total Depth 3310

PRODUCTION

1st 24 hrs. Nat. _____

1st 24 hrs. after shot _____

Gas _____ Cu. Ft.

Dry Hole _____

Abandoned _____

Date _____

JUN 28 1950 19J. E. TYRA Scout