

Form 51-5M-5-34-Palace

Map No. KANSAS Sec. 7 Twp. 14 R. 13 W

Well No. 1, Sullivan Farm

Hartman & Blair Company

NORTH

WEST

EAST

SOUTH

Location_____

Drilling Remarks

Rig Up_____

Drilling Remarks

RECORD

Cased _____ in. _____ ft.

Sand_____

Gas_____

Oil

Total Depth_____

PRODUCTION

1st 24 hrs. Nat.-----

1st 24 hrs. after shot_____

Gas _____ cu. ft. _____

Dry Hole-----

Abandoned_____

Russell

Map No. KANSAS Sec. 2 Twp. 14 R. 15W


Well No. 1 Sullivan Farm
Hartman & Blair Company

330 Ft. from N. Line

_____ Ft. from S. Line

330 Ft. from E. Line

_____ Ft. from W. Line

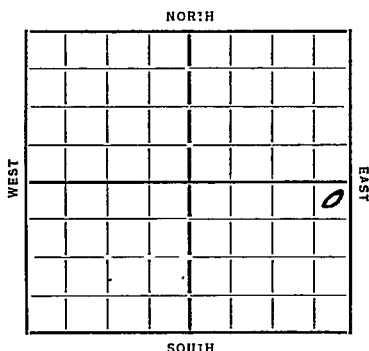

Date 7/23/4

REPORT

12/5 Rig
12/19 _____
12/21 Rgn
12/27 Spud & SD
1/3/35 Dlg 345
1/10 15" 400 Rep. Rig
1/17 Anhydrite 927 10" 957
1/24 Dlg 2010 Salt 1305
1/31 2550 Run 8"
2/7 Dlg 2910
2/14 6" 3060 Oswald 3060
2/20 TJ 3068 HFO Tubing
2/20 Oswald 3060 TJ 3068
270 Bbls.

COMPLETED

Map No. 72 Sec. 2 Twp. 14 R. 15WWell No. 1 - SullivanHartman & Bean Company

Contractor

FIRST REPORTS

SECTION PLAT

330 Ft. from N. Line

Ft. from S. Line

330 Ft. from E. Line

Ft. from W. Line

			0

Location.....

Rig up.....

Drilling and Remarks:

Rig

RECORD

Cased..... in., ft.

Sand.....

Gas.....

Oil.....

Total Depth.....

PRODUCTION

1st 24 hrs. Nat.....

1st 24 hrs. after shot.....

Gas..... Cu. Ft.

Dry Hole.....

Abandoned.....

Date

12-5-34 192.....

ORVAL MANNSCHRECK

Scout

Map No. 72 Sec. 2 Twp. 14 R. 15WWell No. 1 - SullivanHartman & Blair Company

Contractor

COMPLETED**KANSAS SECTION PLAT**330 Ft. from N. Line

Ft. from S. Line

330 Ft. from E. Line

Ft. from W. Line

			0

Location

Rig up

Drilling and Remarks:

220 Hb**RECORD**

Cased in, ft.

Sand Oswald 3060

Gas

Oil

Total Depth 3068**PRODUCTION**

1st 24 hrs. Nat.

1st 24 hrs. after shot

Gas Cu. Ft.

Dry Hole

Abandoned

Date

ORVAL MANNSCHRECK2-20-35 192

Scout