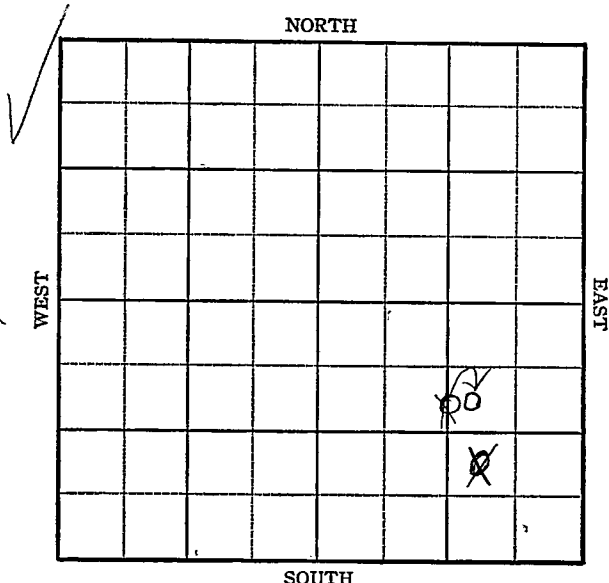


Section 2 Township 14 Range 15-WWell No. #5 ~~#4~~ SullivanCompany I. W. Murfin

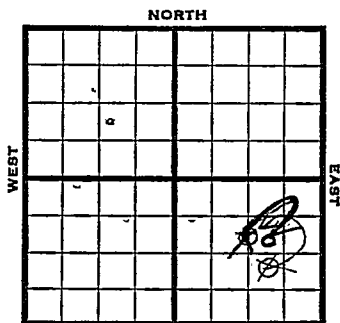
KANSAS

Russell County ✓

Sec. 2 Twp. 14 R. 15WWell No. #4 Sullivan Farm

I. W. Murfin Company

Big Creek

990 Ft. from N. Line990 Ft. from S. Line990 1170 Ft. from E. Line Ft. from W. Line

NW SE SE ~~SW~~ ~~N/2 SE~~ ~~SW NE SE~~

1946 Elev. 1890' REPORT

2/20	RUR
2/28	8" - 930' Anhy 930' Drlg. 1817'
3/7	Lans. 2990' Drlg. 3273'
3/13	Gorham 3314-17' T.D. 7" - 3314'
3/21	" "
3/28	" "
4/4	Drill cement
4/10	" "
4/16	" "
4/23	" "
5/1	" "
5/7	" "
5/14	" "
5/21	" "
5/29	" "
6/5	" "
6/12	" "
6/18	" "
6/26	" "
7/3	" "
7/9	" "
7/16	" "

OVER

KANSAS

Kansas Pool Name Big CreekMap No. 72 Sec. 2 Twp. 14 R. 15WWell No. 4 SullivanI. W. Murfin

Company

FIRST REPORT

Contractor

NW SE SE

SECTION PLAT

			o

 Ft. from N. Line990 Ft. from S. Line990 Ft. from E. Line Ft. from W. LineRussell CountyLocation Rig up

Drilling and Remarks:

RUR

RECORD

Cased in., ft.Sand Gas Oil Total Depth

PRODUCTION

1st 24 hrs. Nat. 1st 24 hrs. after shot Gas Cu. Ft.Dry Hole Abandoned

Date

FEB 20 1946 19S. J. LEWIS Scout

Kansas Pool Name Big Creek

KANSAS
 Map No. 72 Sec. 2 Twp. 14 R. 15W

Well No. 5 Sullivan

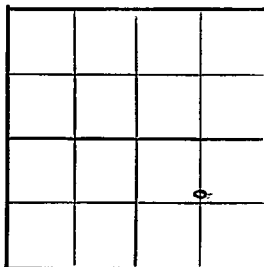
I. W. Murfin
CORRECTION

Company

Contractor

C S L $N\frac{1}{2}$ SE

SECTION PLAT

990 Ft. from N. Line Ft. from S. Line1320 Ft. from E. Line Ft. from W. Line

Russell County

Location

Rig up

Drilling and Remarks:

reported as ~~#4~~

NW SE SE

RECORD

Cased in., ft.Sand Gas Oil Total Depth

PRODUCTION

1st 24 hrs. Nat. 1st 24 hrs. after shot Gas Cu. Ft.Dry Hole Abandoned

Date

FEB 27 1946

19

S. J. LEWIS

Scout

KANSAS

Kansas Pool Name Big CreekMap No. 72 Sec. 2 Twp. 14 R. 15WWell No. 5 SullivanI. W. Murfin

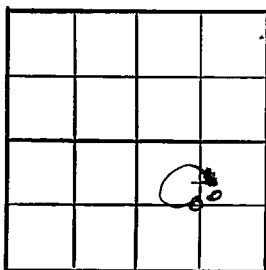
Company

CORRECTION

Contractor

SW NE SE

SECTION PLAT

990 Ft. from N. Line Ft. from S. Line1170 Ft. from E. Line Ft. from W. Line

Russell County

Location

Rig up

Drilling and Remarks:

Reported

C S L N $\frac{1}{2}$ SE

RECORD

Cased in. ft.Sand Gas Oil Total Depth

PRODUCTION

1st 24 hrs. Nat. 1st 24 hrs. after shot Gas Cu. Ft.Dry Hole Abandoned

Date

JUN 19 1946

19

S. J. LEWIS

Scout

KANSAS

Kansas

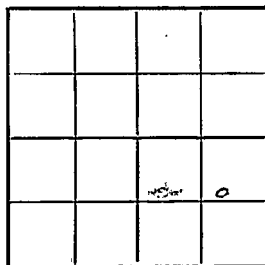
Pool Name Big CreekMap No. 72 Sec. 2 Twp. 14 R. 15WWell No. 5 SullivanI. W. Murfin

Company

COMPLETED

Contractor

SW NE SE

E. 1, 1879
SECTION PLAT990 Ft. from N. Line Ft. from S. Line1170 Ft. from E. Line Ft. from W. Line

Russell County

Location Rig up

Drilling and Remarks:

Graham 33147" @ 3314Lane 2990Ref Lane2000 aciolPump 80 Pot89° 4'

RECORD

Cased in., ft.Sand Gas Oil Total Depth 3317

PRODUCTION

1st 24 hrs. Nat. 1st 24 hrs. after shot Gas Cu. Ft.Dry Hole Abandoned

Date

JUL 24 1946

19

S. J. LEWIS

Scout

1946

7/24 Gorham 3314
7" @ 3314
Lans 2990
Perf. Lans.
2000 acid.
TD 3317
Pump 30 Pot.
Grav. 39.0

COMPLETED