


Form 51-5M-3-35-Mid-West

Map No. **KANSAS** Sec. **2** Twp. **14** R. **15-W**

Well No. **#2 Sullivan** Farm  
**Hartman & Blair** Company

NORTH

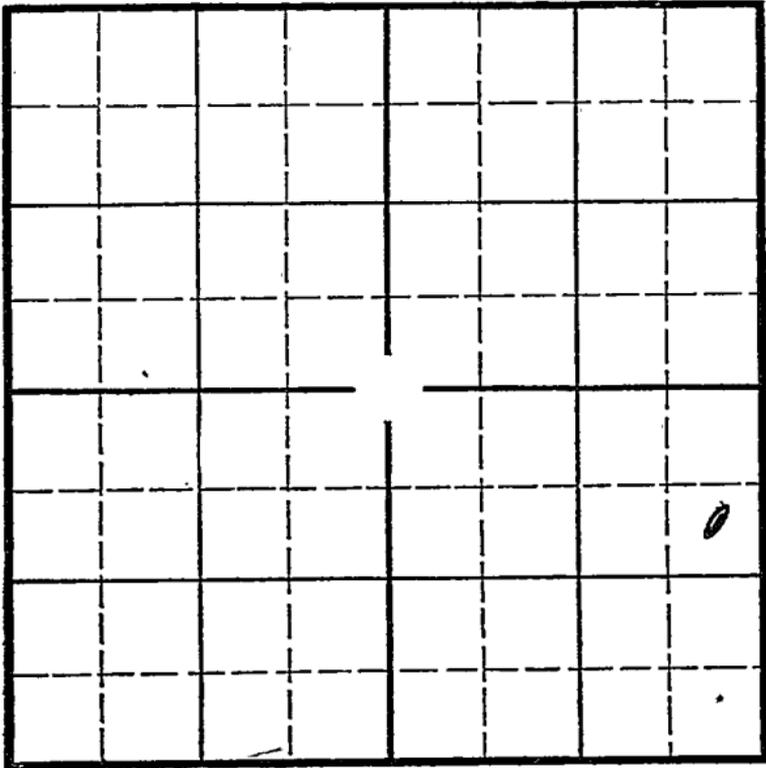

WEST

EAST

SOUTH

Location \_\_\_\_\_  
Drilling Remarks \_\_\_\_\_

Rig Up \_\_\_\_\_  
Drilling Remarks \_\_\_\_\_

\_\_\_\_\_  
\_\_\_\_\_  
RECORD

PRODUCTION

Cased \_\_\_\_\_ in. \_\_\_\_\_ ft.  
Sand \_\_\_\_\_  
Gas \_\_\_\_\_  
Oil \_\_\_\_\_  
Total Depth \_\_\_\_\_


1st 24 hrs. Nat. \_\_\_\_\_  
1st 24 hrs. after shot \_\_\_\_\_  
Gas \_\_\_\_\_ cu. ft. \_\_\_\_\_  
Dry Hole \_\_\_\_\_  
Abandoned \_\_\_\_\_

Russell

Map No.            Sec. 2 Twp. 14 R. 15 W

Well No. 2- Sullivan Farm  
Hartman & Blair Company

990 Ft. from N. Line  
           Ft. from S. Line  
330 Ft. from E. Line  
           Ft. from W. Line  
Elev. 1896

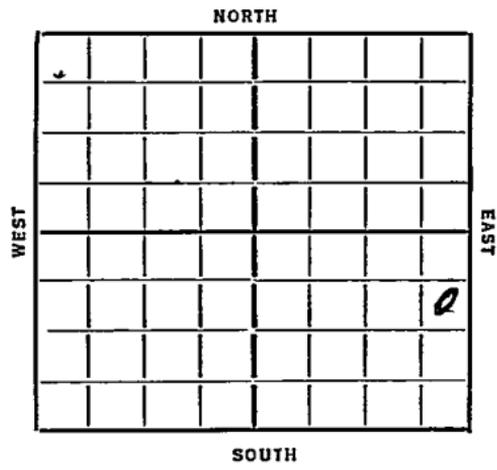

REPORT

- ~~1946~~ 2/12 Location
- 2/21 — 2/28 — 3/6 —
- 3/13 Cellar and Machine.
- 3/20 --
- 3/27 Spud.
- 4/2 15"-368' 12"-572' Drlg. 660'
- 4/10 10"-@ 937' Drlg. 1460'
- 4/16 Drlg. 2200'
- 4/23 Drlg. 2690'
- 4/30 Lansing 3062'. Pay 3080-90' 1500' oil in 3 hours.
- 5/7 Pump 213 bbls in 24 hours. Nat.
- 5/14 --
- 5/21 Acidizing.
- 5/28 Est 19 bbls oil per hour.
- 6/4 --
- 6/11 Shut down.

OVER

6/17/36-Lansing' 3062'.  
Pay 3080-90'.  
2000 gallons acid.  
T.D. 3091'.  
Potential 447 bbls oil.  
22% water.

COMPLETED

Map No. 72 Sec. 2 Twp. 14 R. 15W

Well No. 2 - Sullivan

Hartman & Blair Company

Contractor

FIRST REPORTS

SECTION PLAT

990 Ft. from N. Line

..... Ft. from S. Line

330 Ft. from E. Line

..... Ft. from W. Line

			o

Location

Rig up.....

Drilling and Remarks:

RECORD

Cased..... in., ..... ft.

Sand.....

Gas.....

Oil.....

Total Depth.....

PRODUCTION

1st 24 hrs. Nat.....

1st 24 hrs. after shot.....

Gas..... Cu. Ft.

Dry Hole.....

Abandoned.....

Date

ORVAL MANNSCHRECK

2-12-36 192.....

Scout

Map No. 72 Sec. 2 Twp. 14 R. 15W

Well No. 2 Sullivan

Hartman & Blair Company

Contractor

**SECTION PLAT**

			0

990 Ft. from N. Line

\_\_\_\_\_ Ft. from S. Line

330 Ft. from E. Line

\_\_\_\_\_ Ft. from W. Line

**COMPLETED**

Location \_\_\_\_\_

Rig up \_\_\_\_\_

Drilling and Remarks:

*Waning 3062*  
*Pay 3080-90*  
*2000 acid*  
*Prof. 447 1/2 in*  
*22% water.*

**RECORD**

Cased \_\_\_\_\_ in., \_\_\_\_\_ ft.

Sand \_\_\_\_\_

Gas \_\_\_\_\_

Oil \_\_\_\_\_

Total Depth. 3091

**PRODUCTION**

1st 24 hrs. Nat. \_\_\_\_\_

1st 24 hrs. after shot \_\_\_\_\_

Gas \_\_\_\_\_ Cu. Ft.,

Dry Hole \_\_\_\_\_

Abandoned \_\_\_\_\_

Date

JUN 17 1936

19

S. J. LEWIS

Scout