

KANSAS

Section 2 Township 14 Range 15-W

Well No. #6 Sullivan

Company Murfin Drig.

NORTH

				1			
						0	

SOUTH



Sec. 2 Twp. 14 R. 15W ✓

Well No. #6 Sullivan Farm

Murfin Drlg. Company

Murfin Contractor

Gorham


_____ Ft. from N. Line

990 Ft. from S. Line

990 Ft. from E. Line

_____ Ft. from W. Line

NW SE SE

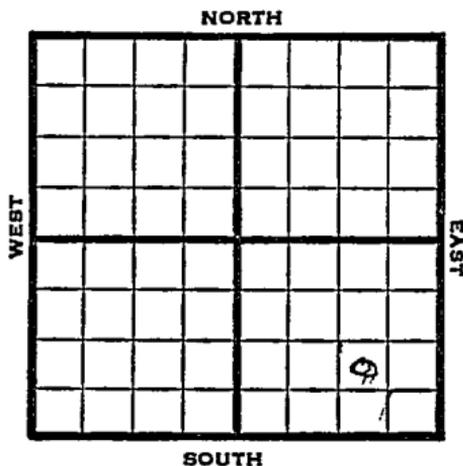

1950

Elev 1890

REPORT

5/10

Rig up

7/5

Anhy 919

8" @ 928

Heeb 3010

Dodge 3035

Lans 3050

Sand 3312-17 TD

5" @ 3313

(Gorham)

Comp 75 bopd

TD 3317

Completed

COMPLETED

Kansas

Map No. _____ Sec. 2 Twp. 14 R. 15W

Well No. 6 Sullivan

Murfin Drlg. _____ Company

Murfin _____ Contractor

NW SE SE


SECTION PLAT

_____ Ft. from N. Line

990 Ft. from S. Line

990 Ft. from E. Line

_____ Ft. from W. Line

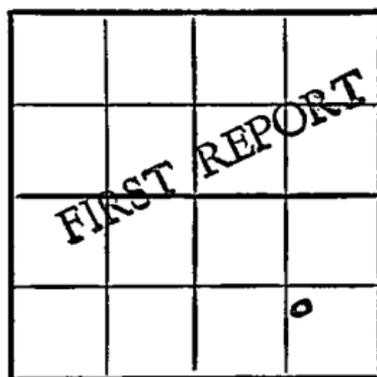

Russell

Location _____

Rig up _____ X

Drilling and Remarks:

RECORD

Cased _____ in., _____ ft.

Sand _____

Gas _____

Oil _____

Total Depth _____

PRODUCTION

1st 24 hrs. Nat. _____

1st 24 hrs. after shot _____

Gas _____ Cu. Ft.

Dry Hole _____

Abandoned _____

Date

MAY 10 1950

19

J. E. TYRA Scout

Kansas

Map No. _____ Sec. 2 Twp. 14 R. 15W

Well No. 6 Sullivan

_____ Murfin Drlg. _____ Company

_____ Contractor

NW SE SE

El. 1890

SECTION PLAT

_____ Ft. from N. Line

990 Ft. from S. Line

990 Ft. from E. Line

_____ Ft. from W. Line

			o

RUSSELL
Graham County

Location _____

Rig up _____

Drilling and Remarks:

Anhy 919

8" o 928

Heeb. 3010

Dodge 3035

Lans. 3050

Doohan Sand 3312-17 TD

5" o 3313

RECORD

Cased _____ in., _____ ft.

Sand _____

Gas _____

Oil _____

Total Depth 3317

PRODUCTION

1st 24 hrs. Nat. _____

1st 24 hrs. after shot _____

Gas _____ Cu. Ft.

Dry Hole _____

Abandoned _____

Comp. 75 bopd

Date

JUL 5 1950 19

J. E. TYRA

Scout