

Map No. **KANSAS** Sec. **2** Twp. **14** R. **15^w**Well No. **1- Johnson** Farm**Empire Oil** Company

NORTH

WEST

EAST

SOUTH

O. W. D. D

Location _____

Drilling Remarks _____

Rig Up _____

Drilling Remarks _____

RECORD

Cased _____ in. _____ ft.

Sand _____

Gas _____

Oil _____

Total Depth _____

PRODUCTION

1st 24 hrs. Nat. _____

1st 24 hrs. after shot _____

Gas _____ cu. ft.

Dry Hole _____

Abandoned _____

Russell

Map No. KAN 8 Sec. 2 Twp. 14 R. 15^W


Well No. 1-Johnson Farm
Empire Oil Company

 Ft. from N. Line

330 Ft. from S. Line

330 Ft. from E. Line

 Ft. from W. Line

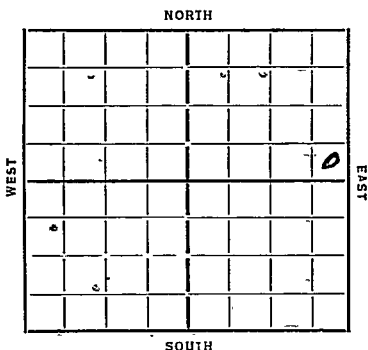

Date 1935 REPORT O. W. D. D

<u>3/6</u>	Location	
<u>3/14</u>	Rog	
<u>3/21</u>	Rgn	
<u>3/28</u>		
<u>4/4</u>	Alg 430	15" 425
<u>4/11</u>	" 945	12" 925
<u>4/18</u>	" 1660	Arkey 935
<u>4/26</u>	" 2320	
<u>5/2</u>	S.O. 2515	10" 2546
	Alg 2735	
<u>5/9</u>	8" 2815	
<u>5/16</u>	8" 3025 Oswald 3069	
	1500' 7 hrs T73070	
<u>5/23</u>	T73073	2400' oil
<u>5/29</u>		
<u>6/5</u>	Oswald 3069 T73073	
	1000 acid 669 Blw.	

COMPLETED

OVER

O. W. D. D

1936

7/8 - OLD TOTAL DEPTH 3073'
DELG. 3089'

7/16-T.D. 3121'. 2000 gallons of acid.
950 bbls of oil. Pump.


7/30-Reaming hole.

8/6-6" @ 3121'. Drlg.

8/13-Dr1g. 3162'.

8/20-Cemented back from 3152 to 3090'.
Clean out 3074'. Had crooked hole.

8/27 Drlg. 3108'.

9/3-Cleaning out @ 3108'.

9/10-6 " @ 3154'. Hole full of water.
3157'. T.D. 3182'. Under ream 6".

9/18-3310' Under ream 6".

9/24--

10/1-6" @ 3320'. Waiting on cement.

10/7/36-Sil. 3320'.

T.D. 3322'.

Pump 801 bbls of oil.

COMPLETED

KANSAS

Map No. 77 Sec. 2 Twp. 14 R. 15W

Well No. 1- Johnson

Empire oil Company

Contractor

FIRST REPORTS

.....Ft. from N. Line

330 Ft. from S. Line

330 Ft. from E. Line

.....Ft. from W. Line

SECTION PLAT

			0

Location ✓

Rig up

Drilling and Remarks:

RECORD

Cased.....in.,ft.

Sand

Gas

Oil

Total Depth

PRODUCTION

1st 24 hrs. Nat.

1st 24 hrs. after shot

Gas Cu. Ft.

Dry Hole

Abandoned

Date

3-6-35 192.....

ORVAL MANNSCHRECK

Scout

Map No. 72 Sec. 2 Twp. 14 R. 15WWell No. 1 - JohnsonEmpire oil Company

Contractor

SECTION PLAT

			0

Ft. from N. Line

330 Ft. from S. Line330 Ft. from E. Line

Ft. from W. Line

Location

Rig up

Drilling and Remarks:

1000 and669 bbls

RECORD

Cased _____ in. _____ ft.

Sand Oswald 3069

Gas _____

Oil _____

Total Depth 3073

PRODUCTION

1st 24 hrs. Nat. _____

1st 24 hrs. after shot _____

Gas _____ Cu. Ft.

Dry Hole _____

Abandoned _____

Date

6-5-35 192 DR. J. MANNING Scout

Map No. 72 Sec. 2 Twp. 14 R. 15WWell No. JohnsonCompany Engelke

Contractor _____

SECTION PLAT

			0

_____ Ft. from N. Line

320 Ft. from S. Line320 Ft. from E. Line

_____ Ft. from W. Line

FIRST REPORT

OW II

Location _____

Rig up _____

Drilling and Remarks:

Old TII 3073Daly 3089

RECORD

Cased _____ in., _____ ft.

Sand _____

Gas _____

Oil _____

Total Depth _____

PRODUCTION

1st 24 hrs. Nat. _____

1st 24 hrs. after shot _____

Gas _____ Cu. Ft.

Dry Hole _____

Abandoned _____

Date

JUL 8 1936 19 S. J. LEWIS Scout

KANSAS

Map No. 72 Sec. 2 Twp. 14 R. 15WWell No. JohnsonEschier Company

Contractor

SECTION PLAT

			0

 Ft. from N. Line330 Ft. from S. Line330 Ft. from E. Line Ft. from W. Line

COMPLETED

Location Rig up

Drilling and Remarks:

Oil 3320Pump 801

RECORD

Cased in., ft.Sand Gas Oil Total Depth 3322

PRODUCTION

1st 24 hrs. Nat. 1st 24 hrs. after shot Gas Cu. Ft.Dry Hole Abandoned

Date

OCT 7 1936 19 S. J. LEWIS Scout