

KANSAS

Form 51-5M-436-Palace


Russell

Section 2 Township 14 Range 15-W

Well Number #5 Johnson

Company Texas

NORTH

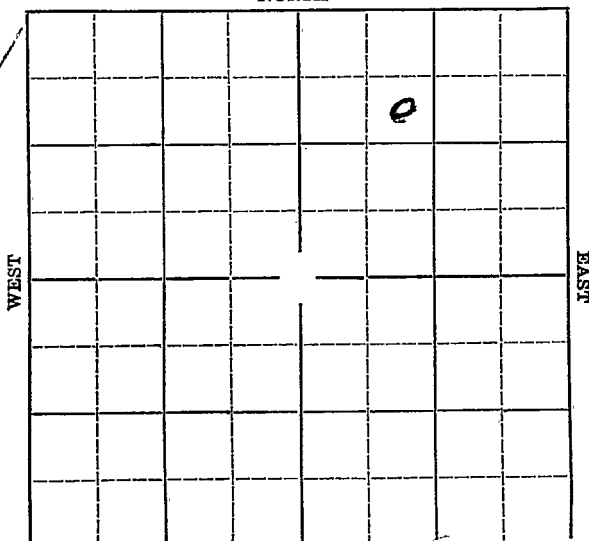

SOUTH

KANSAS

Map No. 12 Sec. 2 Twp. 14 R. 15WWell No. 5 JohnsonThomas Company

Contractor

SECTION PLAT

990 Ft. from N. Line

_____ Ft. from S. Line

_____ Ft. from E. Line

990 Ft. from W. Line

FIRST REPORT

Location _____

Rig up _____

Drilling and Remarks:

Building rig

RECORD

Cased _____ in., _____ ft.

Sand _____

Gas _____

Oil _____

Total Depth _____

PRODUCTION

1st 24 hrs. Nat. _____

1st 24 hrs. after shot _____

Gas _____ Cu. Ft.

Dry Hole _____

Abandoned _____

Date

OCT 28 1936 19 S. J. LEWIS Scout

KANSAS

Map No. 72 Sec. 2 Twp. 14 R. 15WWell No. 5 JohnsonJ.P. Pearson Company

Contractor

SECTION PLAT

		o	

990 Ft. from N. Line

_____ Ft. from S. Line

_____ Ft. from E. Line

990 Ft. from W. Line

COMPLETED

Location _____

Rig up _____

Drilling and Remarks:

D-1046630603000 acidP-8343 oil40 water

RECORD

Cased _____ in., _____ ft.

Sand _____

Gas _____

Oil _____

Total Depth 3140

PRODUCTION

1st 24 hrs. Nat. _____

1st 24 hrs. after shot _____

Gas _____ Cu. Ft.

Dry Hole _____

Abandoned _____

Date

DEC 16 1936 19

S. J. LEWIS

Scout