

KANSAS


Form 51-5M-4-36-Palace

Russell

Section 2 Township 14 Range 15-W

Well Number #7-Johnson


Company Empire

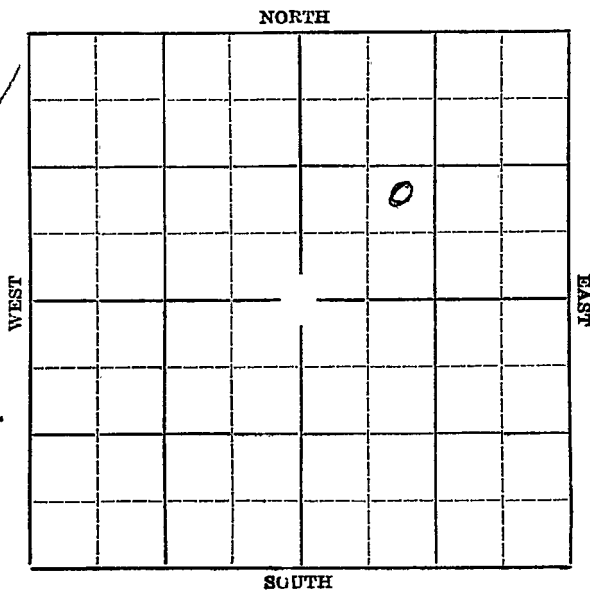

Map No. KANSAS Sec. 2 Twp. 14 R. 15WWell No. #7 Johnson FarmEmpire

Company

NORTH

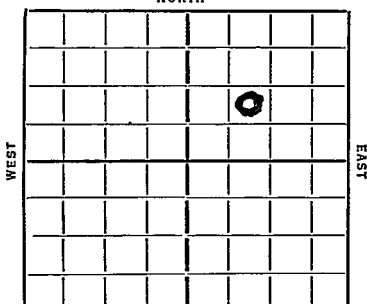

Ft. from N. Line

990' Ft. from S. Line

Ft. from E. Line

990' Ft. from W. Line

Elev. 1898

SOUTH

Date	REPORT
<u>1936</u>	
<u>6/24</u>	<u>Rig on ground.</u>
<u>7/2</u>	<u>Rigging up.</u>
<u>7/9</u>	<u>Drlg. 600'.</u>
<u>7/16</u>	<u>Anhy. 930'. T.D. 940' U.R. 12".</u>
<u>7/23</u>	<u>Drlg. 1750'.</u>
<u>7/30</u>	<u>Drlg. 1755'. Have been shut down</u> <u>for water.</u>
<u>8/6</u>	<u>Drlg. 2255'.</u>
<u>8/13</u>	<u>Drlg. 2555'.</u>
<u>8/20</u>	<u>2565' under ream 10".</u>
<u>8/27</u>	<u>Topeka 2985'. 740' of oil and 3 hrs</u> <u>1 bailer of water.</u>
<u>9/3</u>	<u>Lansing 3047'. TD 3153'. UR 8".</u>
<u>9/10</u>	<u>8" @ 3143'. Gorham 3299'. 400'</u> <u>of fluid 1 3/4 hours. TD 3300'.</u>
<u>9/18</u>	<u>3313'. Hole full of water. P.B.</u> <u>to 3150'.</u>
<u>9/24</u>	<u>Drlg. 3050'.</u>
<u>10/1</u>	<u>3060'-700' fluid in hole.</u>
<u>10/8</u>	<u>Shut down.</u>

OVER

10/14/36-Gorham 3299'.

T.D. 3300'.

Plug back to 3100'.

1000 gallons of acid.

Potential 703 bbls of oil

6% water.

COMPLETED

KANSAS

Map No. 72 Sec. 2 Twp. 14 R. 15WWell No. 7 JohnsonEmpire

Company

Contractor

SECTION PLAT

		0	

 Ft. from N. Line920 Ft. from S. Line Ft. from E. Line990 Ft. from W. Line

FIRST REPORT

Location Rig up

Drilling and Remarks:

RCY

RECORD

Cased in., ft.Sand Gas Oil Total Depth

PRODUCTION

1st 24 hrs. Nat. 1st 24 hrs. after shot Gas Cu. Ft.Dry Hole Abandoned

Date

JUN 24 1936

19

S. J. LEWIS Scout

Map No. 72 Sec. 2 Twp. 14 R. 15W

Well No. Johnson

Empire Company

Contractor

SECTION PLAT

		0	

1 Ft. from N. Line

990 Ft. from S. Line

 Ft. from E. Line

990 Ft. from W. Line

COMPLETED

RECORD

Location

Rig up

Drilling and Remarks:

Got hole 3299

P.B. 3100

1000 ac oil

P 8703-

6 9/16 water

Cased in., ft.

Sand

Gas

Oil

Total Depth 3300

PRODUCTION

1st 24 hrs. Nat.

1st 24 hrs. after shot

Gas Cu. Ft.

Dry Hole

Abandoned

Date

OCT 14 1936

19

S. J. LEWIS

Scout