

Russell KANSAS


Section 2 Township 14 ~~15~~ Range 15 WWell No. # 9 Johnson "A"Company Cities Service Oil

NORTH

WEST

EAST

SOUTH

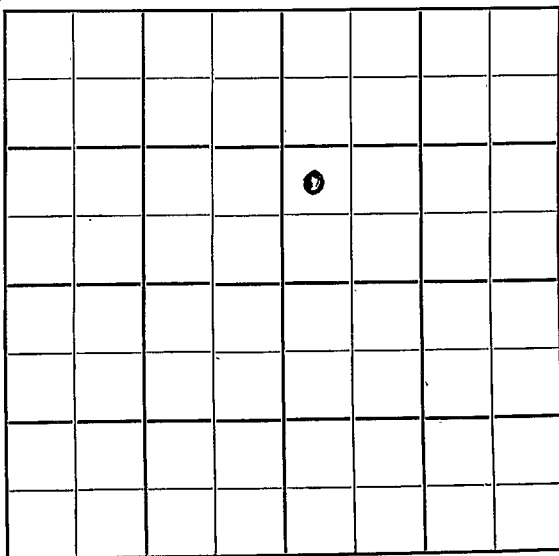

Russell

KANSAS

Sec. 2 Twp. 14 R. 15W

Well No. #9 Johnson "A" Farm

Cities Service Co. Company

Lohman & Johnson Contractor


 Ft. from N. Line

990 Ft. from S. Line

 Ft. from E. Line

380 Ft. from W. Line

NW SW NE

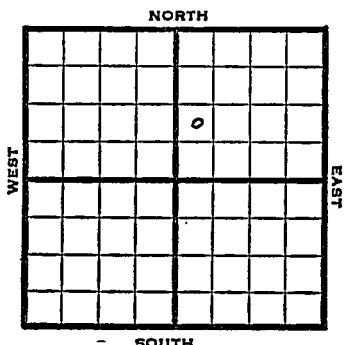

1952

Elev. 1899' REPORT

10/1 Spud 9-28-52
8" @ 242
Drlg. 960

10/8 Drlg. 2527'

10/15 1st Tarkio 2461, 2nd Tarkio 2485
RTD 2610, 4½" @ 2609, CO to 2581
40/2531-42, 1000A

10/22 P/46 BO & 290 BWPD

10/29 NR


11/5 "

11/12 "

11/19 Spud 9-28-52 Oil well TD 2610'
8" @ 242 1st Tarkio 2461' 2nd
Tarkio 2485' TD 2610' 4½" @ 2609
CO to 2581' 40/2531-42 1000 A
P/46 BO 270 BWPD
Comp. 2 BOPD 28 BW

COMPLETED

County Russell State Kansas
 Sec. 2 (Blk.) 14 (Sur.) 15W Map No.
 Operator Cities Service Oil
 Well No. 9 Farm Johnson "A"
 Elev. Location NW SW NE

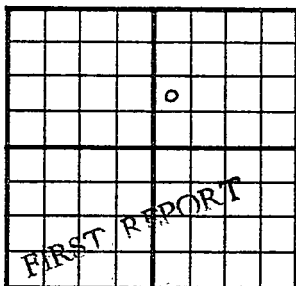

990 Ft. From S Line NE
380 Ft. From W Line Quarter

Ist. Report OCT 1 1952

Completion

Remarks

Lohman & Johnson - Contr.


Spudding Date 9-28-52

Drlg. Data

8" @ 242 drlg. 960

J. G. McGEHEE

County Russell State Kansas
 Sec. 2 (Blk.) 14 (Sur.) 15W Map No.
 Operator Cities Service Oil
 Well No. 9 Farm Johnson "A"
 Elev. 1899 Location NW SW NE

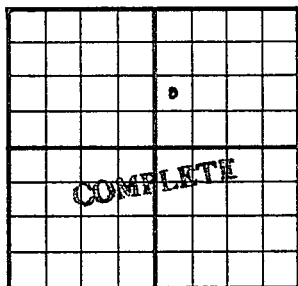

990 Ft. From S Line NE
380 Ft. From W Line Quarter

1st. Report

Completion NOV 19 1952

Remarks

Lohman & Johnson - Contr

Spudding Date 9-28-52

Drlg. Data Oil well TD 2610

8" @ 242 1st Tarkio 2461 2nd Tarkio 2485

TD 2610 4 1/8" @ 2609 CO to 2581

40/ 2531-42 1000 A P/ 46 bo 270 bwpd

Comp. 2 bopd 28 bw

J. G. McGEHEE