




Russell

Map No. KANOGAS Sec. 2 Twp. 14 R. 15<sup>th</sup>

Well No. 2- Pierce Farm  
Gulf Oil Company

330 Ft. from N. Line  
\_\_\_\_ Ft. from S. Line  
\_\_\_\_ Ft. from E. Line  
990 Ft. from W. Line  
Elev. 1889

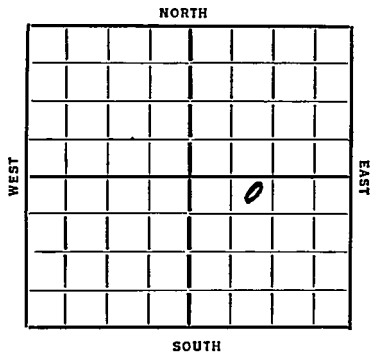

REPORT

<u>1936</u>	
<u>3/4</u>	<u>Std Rig</u>
<u>3/13</u>	<u>---</u>
<u>3/20</u>	<u>--</u>
<u>3/27</u>	<u>Anhy 915 Drlg. 923'</u>
<u>4/2</u>	<u>15"-278' 10"- 925' Drlg. 1900'</u>
<u>4/10</u>	<u>8"@ 2570' Drlg. 2895'</u>
<u>4/16</u>	<u>Oswald 3051' S.O. 3096'-3100'</u> <u>T.D. 3122' Plugged back 3114'-</u> <u>4 1/2 bbls per hour. Natural.</u>
<u>4/23</u>	<u>Swabbing &amp; C.O.</u>
<u>4/30</u>	<u>Lansing 3060'. Corrected T.D. 3122'</u> <u>45 bbls in 10 hours.</u>
<u>5/7</u>	<u>Pump 56 bbls. Natural.</u>
<u>5/14</u>	<u>S.O. <del>327</del> 3140'-43'. Drlg. 3292'.</u>
<u>5/20</u>	<u>/36- Gorham 3310'</u> <u>T.D. 3311'</u> <u>Pump 948 bbls pot.</u>
	<b>COMPLETED</b>

Map No. 72 Sec. 2 Twp. 14 R. 15<sup>W</sup>

Well No. 2-Pierce

Sulf oil

Company

Contractor

**FIRST REPORTS**

330 Ft. from N. Line

..... Ft. from S. Line

..... Ft. from E. Line

990 Ft. from W. Line

**SECTION PLAT**

		0	

Location.....

Rig up.....

Drilling and Remarks:

*Std. Rig*

**RECORD**

Cased.....in., .....ft.

Sand.....

Gas.....

Oil.....

Total Depth.....

**PRODUCTION**

1st 24 hrs. Nat.....

1st 24 hrs. after shot.....

Gas.....Cu. Ft.

Dry Hole.....

Abandoned.....

Date

3-4-36 192

**ORVAL MANNSPERRY**

Scout

*Russell*  
 Map No. 72 Sec. 2 Twp. 14 R. 15W

Well No. 2 Pierce

Gulf. Oil Company

Contractor

**SECTION PLAT**

		0	

330 Ft. from N. Line

\_\_\_\_\_ Ft. from S. Line

\_\_\_\_\_ Ft. from E. Line

990 Ft. from W. Line

**COMPLETED**

Location \_\_\_\_\_

Rig up \_\_\_\_\_

Drilling and Remarks:

*Gochan 3310*  
*Pump 248 8/16*  
*P. J.*

**RECORD**

Cased \_\_\_\_\_ in., \_\_\_\_\_ ft.

Sand \_\_\_\_\_

Gas \_\_\_\_\_

Oil \_\_\_\_\_

Total Depth 3311

**PRODUCTION**

1st 24 hrs. Nat. \_\_\_\_\_

1st 24 hrs. after shot \_\_\_\_\_

Gas \_\_\_\_\_ Cu. Ft.

Dry Hole \_\_\_\_\_

Abandoned \_\_\_\_\_

Date

MAY 20 1936

S. J. LEWIS Scout