

Section 2 Township 14 Range 15W

Well Number 3 Pierce


Company Gulf

NORTH

WEST


EAST

SOUTH

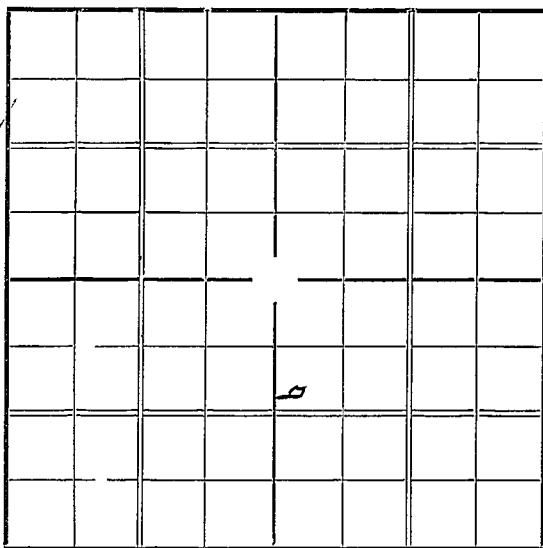

Sec. 2 Twp. 14 R. 15-WWell No. #3 Pierce FarmGulf Company990 Ft. from N. Line Ft. from S. Line Ft. from E. Line330 Ft. from W. Line

Elev. 1887

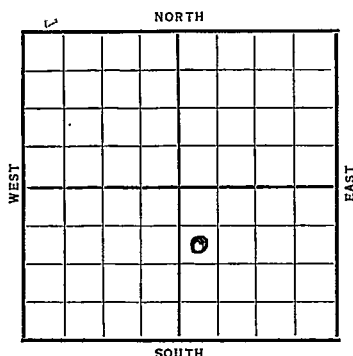

Date	REPORT
1/13	Cellar
1/21	Rig.
1/28	Rigging up.
2/4	15" @ 367 Clean out
2/11	12" @ 570
	Anhydreat 911, 10" @ 915 Drlg. 1215'.
2/19	Drlg. 2205'
2/26	8" @ 2516, 12" @ 2745 Drlg.
3/4	Drlg. 3260'.
3/11	6" @ 3298 Gorham.
	Drlg. 3300'.
3/18	Shut Down
3/25	TD 3306'. No test.
3/31	Gorham Sand 3298'.
	T. D. 3306'.
	Potential 404.
	COMPLETED

Map No. 72 Sec. 2 Twp. 14 R. 15W

Well No. 3 Price

Gulf. Company

Contractor

SECTION PLAT

		0	

990 Ft. from N. Line

_____ Ft. from S. Line

_____ Ft. from E. Line

230 Ft. from W. Line

FIRST REPORT

Location _____

Rig up _____

Drilling and Remarks:

Ce/Hor

RECORD

Cased _____ in., _____ ft.

Sand _____

Gas _____

Oil _____

Total Depth _____

PRODUCTION

1st 24 hrs. Nat. _____

1st 24 hrs. after shot _____

Gas _____ Cu. Ft.

Dry Hole _____

Abandoned _____

Date

JAN 13 1937 19

S. J. LEWIS

Scout

KANSAS *Russell*Map No. _____ Sec. 2 Twp. 14 R. 15WWell No. 3 PisiceGulf Company

Contractor

SECTION PLAT

		0	

990 Ft. from N. Line

_____ Ft. from S. Line

_____ Ft. from E. Line

330 Ft. from W. Line

COMPLETED

RECORD

Location _____

Cased _____ in., _____ ft.

Rig up _____

Sand _____

Drilling and Remarks:

Gas _____

Gorham Sand

Oil _____

*3298*Total Depth 3306

PRODUCTION

Potential

1st 24 hrs. Nat. _____

40.4

1st 24 hrs. after shot _____

Gas _____ Cu. Ft.

Dry Hole _____

Abandoned _____

Date

MAR 31 1937 19

S. J. LEWIS Scout