


Section 2 Township 14 Range 15-W

Well Number #5-Rouback

Company Hartman & Blair

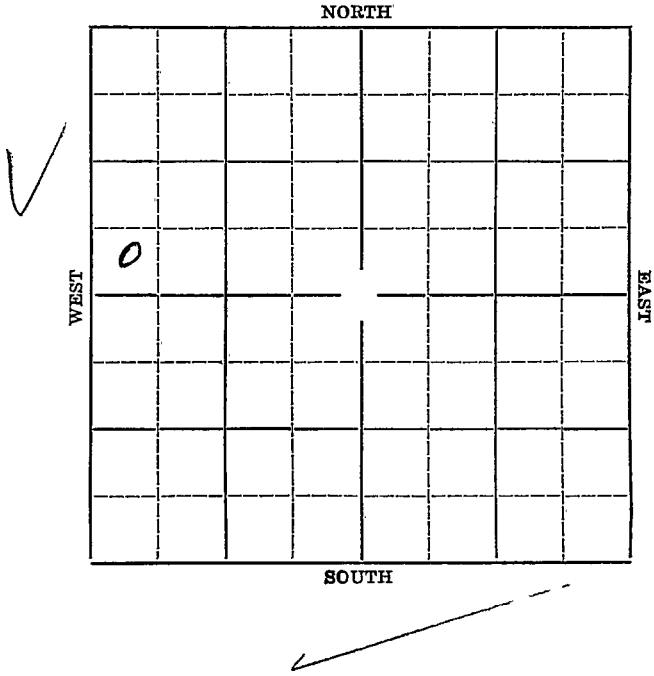


Sec. 2 Twp. 14 R. 15WWell No. #5 Rouback FarmHartman & Blair Company

NORTH

 Ft. from N. Line330' Ft. from S. Line Ft. from E. Line330' Ft. from W. Line

Elev. 1872

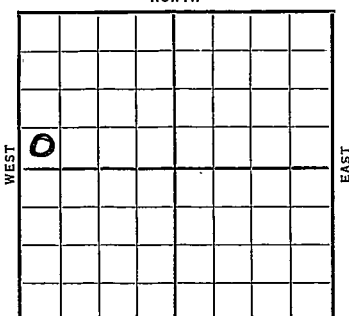~~1936~~

REPORT

9/23 Ponds.

10/1--

10/8 Rig.

10/15 Spud.

10/22 15" @ 365'. 12" @ 605'. Anhy.

907'. 10" @ 913'. Drlg. 1425'.

10/29 Drlg. 2185'.

11/6 8" @ 2515 Topeka 2720

1400' oil 2720-27 SD

11/12 Lansing 3062 T. D. 3063

Flow 2768 bbls.

11/18 Lansing 3062 T. D. 3063

Flow 2768 bbls.

COMPLETED

KANSAS

Map No. 72 Sec. 2 Twp. 14 R. 15WWell No. 5 Roundback.Hartman & Blair Company

Contractor

SECTION PLAT

a			

_____ Ft. from N. Line

330 Ft. from S. Line

_____ Ft. from E. Line

330 Ft. from W. Line

FIRST REPORT

Location _____

Rig up _____

Drilling and Remarks:

Ponds.

RECORD

Cased _____ in., _____ ft.

Sand _____

Gas _____

Oil _____

Total Depth _____

PRODUCTION

1st 24 hrs. Nat. _____

1st 24 hrs. after shot _____

Gas _____ Cu. Ft.

Dry Hole _____

Abandoned _____

Date

SEP 23 1936

19

S. J. LEWIS

Scout

KANSASMap No. 72 Sec. 2 Twp. 14 R. 15WWell No. 5 RoundbackHartman & Blair Company

Contractor

SECTION PLAT

0			

330 Ft. from N. Line330 Ft. from S. Line330 Ft. from E. Line330 Ft. from W. Line**COMPLETED**

Location _____

Rig up _____

Drilling and Remarks:

Logging 3062Flow 2768 gph**RECORD**

Cased _____ in., _____ ft.

Sand _____

Gas _____

Oil _____

Total Depth 3062**PRODUCTION**

1st 24 hrs. Nat. _____

1st 24 hrs. after shot _____

Gas _____ Cu. Ft.

Dry Hole _____

Abandoned _____

Date

NOV 18 1936₁₉S. J. LEWIS Scout