
Form 51-5M 5-37 Petrol

Russell KANSAS

Section 2 Township 14 Range 15-W

Well No. 9 - Rouback

Company Hartman & Blair

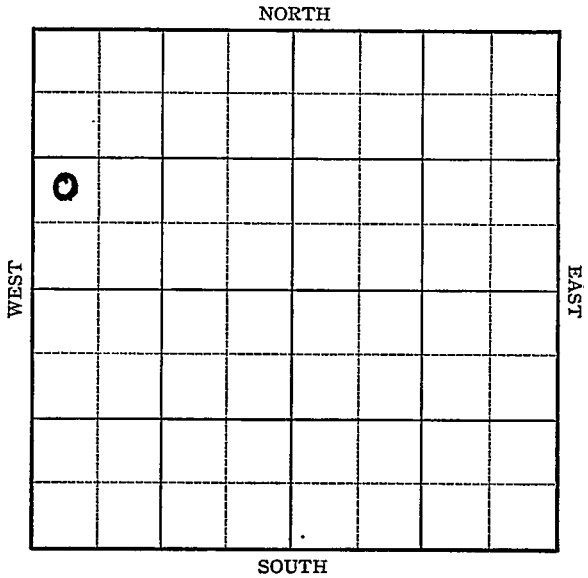


Form 252-A—5M—7-36—Palace

KANSAS Russell

Sec. 2 Twp. 14 R. 15-W

Well No. #9 Rouback Farm

~~Hartman & Blair~~ Company

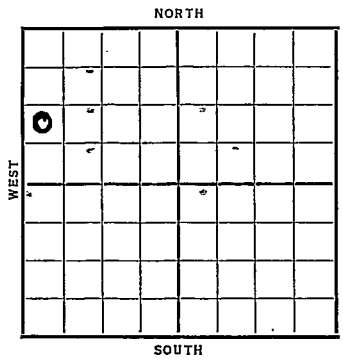

____ Ft. from N. Line

990 Ft. from S. Line

____ Ft. from E. Line

330 Ft. from W. Line

Elev. 1875

Date	REPORT
1937	
5/26	Cellar
6/4	Mat. on gr.
6/11	" "
6/19	R. U.
6/25	15" @ 362'. 12" @ 614'.
	Drlg. 820'.
7/2	10" @ 923'. Drlg. 2035'.
7/9	8" @ 2504'. Drlg. 2675'.
7/16	Lansing 3039'. H.F.W. 3130'.
	Drlg. 3150'.
7/23	SD 3150'.
7/30	5" @ 3290'. T.D. 3294'.
	Testing.

OVER

1937
8/4 5" @ 3290'.
Sil. 3290'.
T.D. 3294'.
Pot. 1615 bbls.

COMPLETED

Form 26—1M Bks.—2-29 Russell KANSAS

Map No. _____ Sec. 2 Twp. 14 R. 15 W

Well No. 9 - Roubachs

Hartman & Blair Company

_____ Contractor

FIRST REPORT


_____ Ft. from N. Line

990 Ft. from S. Line

_____ Ft. from E. Line

330 Ft. from W. Line

SECTION PLAT

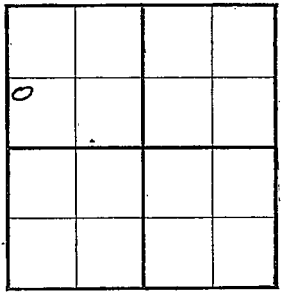

Location _____

Rig up _____

Drilling and Remarks:

Cellar

RECORD

Cased _____ in., _____ ft.

Sand _____

Gas _____

Oil _____

Total Depth _____

PRODUCTION

1st 24 hrs. Nat. _____

1st 24 hrs. after shot _____

Gas _____ Cu. Ft.

Dry Hole _____

Abandoned _____

Date

MAY 26 1937 19

W. B. Hatfield Scout

Form 26—1M Bks.—2-29 Russell KANSAS

Map No. _____ Sec. 2 Twp. 14 R. 15W

Well No. 9- Rouback

Hartman & Blair Company

_____ Contractor

COMPLETED


_____ Ft. from N. Line

990 Ft. from S. Line

_____ Ft. from E. Line

330 Ft. from W. Line

SECTION PLAT

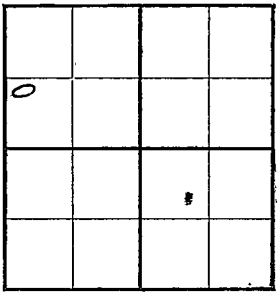

Location _____

Rig up _____

Drilling and Remarks:

Pot- 1615

RECORD

Cased 5 in., 3290 ft.

~~Sand~~ Sil 3290

Gas _____

Oil _____

Total Depth 3294

PRODUCTION

1st 24 hrs. Nat. _____

1st 24 hrs. after shot _____

Gas _____ Cu. Ft.

Dry Hole _____

Abandoned _____

Date

AUG 4 - 1937 19 H. D. Hatfield Scout