

Section 2 Township 14 Range 15-W


Well Number 8 Rouback

Company Hartman & Blair

*Twin Well*


NORTH

WEST

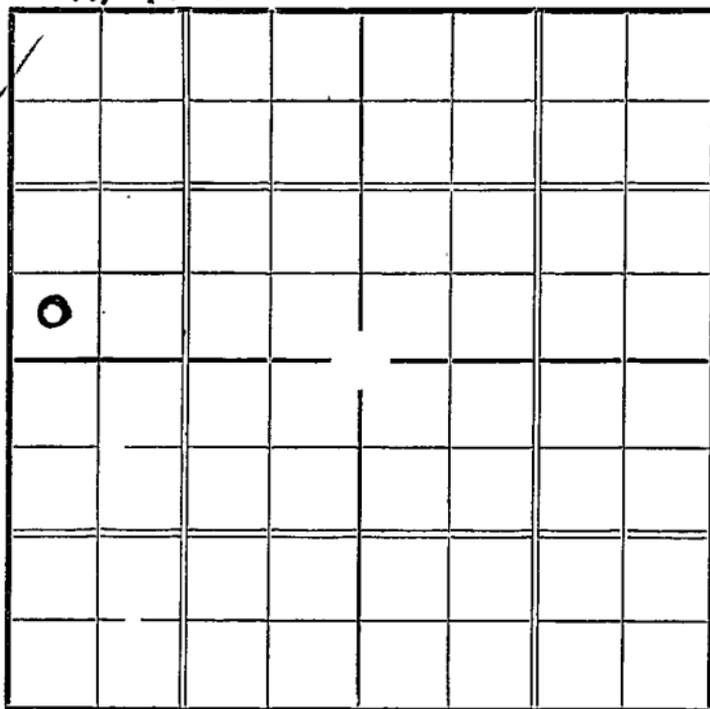

EAST

SOUTH

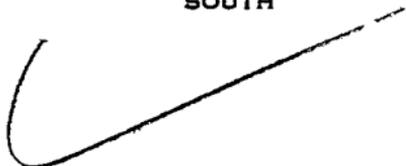

Sec. 2 Twp. 14 R. 15-W


Well No. #8 Rouback Farm  
Hartman & Blair Company

\_\_\_\_\_ Ft. from N. Line

330 Ft. from S. Line

\_\_\_\_\_ Ft. from E. Line

330 Ft. from W. Line

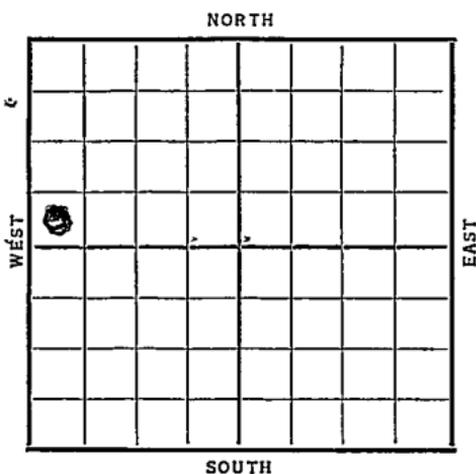

Twin well.

Date	Elev. 1875	REPORT
<del>1/3/27</del>		
2/24		Rig
3/4		"
3/11		Rigging up.
3/18		Shut Down
3/25	" "	
4/2	" "	
4/8		Rigging up.
4/16		15" @ 365' Drlg. 485'
4/23		12" @ 615'. 10" @ 920'. Drlg. 1870'.
4/30		8" @ 2400'. Drlg. 2515'.
5/7		8" @ 2518'. Topoka 2700'. H.F.O. 2710-20'.
		45 Min. 7" @ 2785'. C.O.
5/14	" " " "	" " " "
5/21		Osw. 3045'. 5" @ 3230'. Clean out.
5/28	" "	
		<b>OVER</b>

1937

6/2

5" @ 3294' .

Gorham 3294' .

T.D. 3298' .

Potential 2700 bbls. 24 hrs.

**COMPLETED**

# KANSAS

Map No. \_\_\_\_\_ Sec. 2 Twp. 14 R. 15W

Well No. 8 Roubach

Hartman & Blair Company

Contractor

*Twin well*

### SECTION PLAT

<i>0</i>			

\_\_\_\_\_ Ft. from N. Line

330 Ft. from S. Line

\_\_\_\_\_ Ft. from E. Line

330 Ft. from W. Line

## FIRST REPORT

Location \_\_\_\_\_

Rig up \_\_\_\_\_

Drilling and Remarks:

*Rig*

### RECORD

Cased \_\_\_\_\_ in., \_\_\_\_\_ ft.

Sand \_\_\_\_\_

Gas \_\_\_\_\_

Oil \_\_\_\_\_

Total Depth \_\_\_\_\_

### PRODUCTION

1st 24 hrs. Nat. \_\_\_\_\_

1st 24 hrs. after shot \_\_\_\_\_

Gas \_\_\_\_\_ Cu. Ft.

Dry Hole \_\_\_\_\_

Abandoned \_\_\_\_\_

Date

FEB 24 1937 19

S. J. LEWIS Scout

