


Well Number 14 Crawford

Company Empire

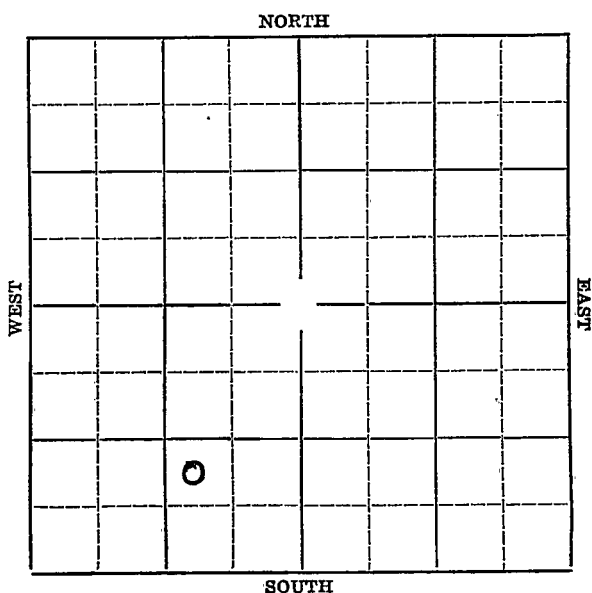

1937

6/16 7" @ 3297'.

Gorham 3297'.

T.D. 3300'.


Pot. 1305 bbls.

COMPLETED

KANSAS*Russell*Map No. _____ Sec. 2 Twp. 14 R. 15W.Well No. 14 CrawfordEmpire

Company

Contractor

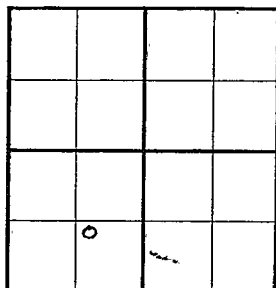SECTION PLAT1661 Ft. from N. Line

_____ Ft. from S. Line

998 Ft. from E. Line

_____ Ft. from W. Line

FIRST REPORTLocation ✓

Rig up _____

Drilling and Remarks:

RECORD

Cased _____ in., _____ ft.

Sand _____

Gas _____

Oil _____

Total Depth _____

PRODUCTION

1st 24 hrs. Nat. _____

1st 24 hrs. after shot _____

Gas _____ Cu. Ft.

Dry Hole _____

Abandoned _____

Date

APR 21 1937 19

S. J. LEWIS Scout

Russell KANSAS

Map No. 72 Sec. 2 Twp. 14 R. 15^WWell No. 14- CrawfordEmpire Company

Contractor

COMPLETED

1661 Ft. from N. Line

_____ Ft. from S. Line

998 Ft. from E. Line

_____ Ft. from W. Line

SECTION PLAT

	0		

Location _____

Rig up _____

Drilling and Remarks: _____

Pot - 1305

RECORD

Cased 7 in., 3297 ft.Sand Gorham 3297

Gas _____

Oil _____

Total Depth 3300

PRODUCTION

1st 24 hrs. Nat. _____

1st 24 hrs. after shot _____

Gas _____ Cu. Ft.

Dry Hole _____

Abandoned _____

Date

JUN 16 1937 19 H. D. Hatfield = Scout