


Section..... 2 Township..... 14 Range..... 15-W

Well Number..... 15 - Crawford


Company..... Empire

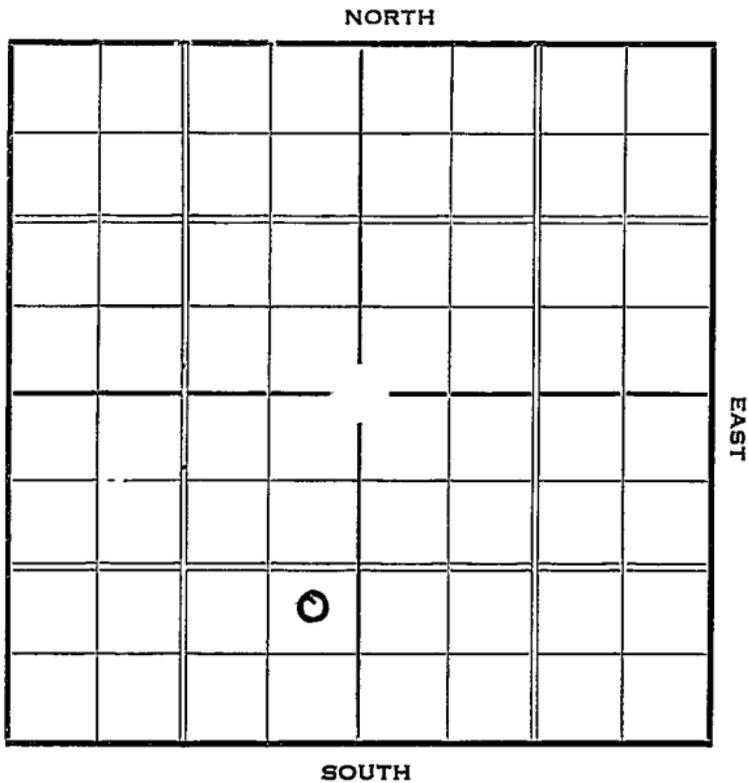

Sec. 2 Twp. 14 R. 15-W

Well No. #15 Crawford Farm
Empire Company

 Ft. from N. Line
990 Ft. from S. Line
330 Ft. from E. Line
 Ft. from W. Line
 Elev. 1882

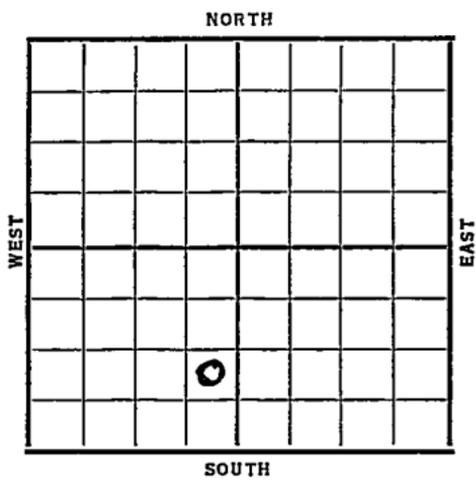

Date	REPORT
1937	
5/5	B. R.
5/14	Rig'n up
5/21	15" @ 600'. Drlg. 740'.
5/28	Anhy 905'. 12" @ 915'.
	Drlg. 1815'.
6/4	10" @ 2518'. Drlg. 2520'.
6/11	S.O. 2665-70'.
	Topeka 2765'. Dodge 3025'.
	Drlg. 3030'.
6/19	K.C. 3065'. 8" @ 3068'.
	7" @ 3290'. Gorham 3321'.
	Drlg. 3322'.
6/23	Gorham 3321'.
	T.D. 3423'.
	1000' oil & 1300' water.
	ABANDONED

Map No. 72 Sec. 2 Twp. 14 R. 15^w

Well No. 15 - Crawford

Empire Company

Contractor

FIRST REPORT

SECTION PLAT

_____ Ft. from N. Line

990 Ft. from S. Line

330 Ft. from E. Line

_____ Ft. from W. Line

	o		

Location _____

Rig up _____

Drilling and Remarks: _____

B. R.

RECORD

Cased _____ in., _____ ft.

Sand _____

Gas _____

Oil _____

Total Depth _____

PRODUCTION

1st 24 hrs. Nat. _____

1st 24 hrs. after shot _____

Gas _____ Cu. Ft.

Dry Hole _____

Abandoned _____

Date

MAY 5 - 1937

19

H. D. Hatfield Scout

Russell KANSAS

Map No. 72 Sec. 2 Twp. 14 R. 15^wWell No. 15-CrawfordEmpire Company

Contractor

ABANDONED

SECTION PLAT

 Ft. from N. Line990 Ft. from S. Line530 Ft. from E. Line Ft. from W. Line

		0	

Location _____

Rig up _____

Drilling and Remarks:

1000' oil & 1300' wat,D & A

RECORD

Cased _____ in., _____ ft.

Sand Gorham 3321

Gas _____

Oil _____

Total Depth 3423

PRODUCTION

1st 24 hrs. Nat. _____

1st 24 hrs. after shot _____

Gas _____ Cu. Ft.

Dry Hole _____

Abandoned _____

Date

JUN 23 1937 19H. D. Hatfield Scout