

KANSAS


Form 51-5M-4-36-Palace

Russell

Section 2 Township 14 Range 15-W

Well Number #8-Crawford

Company Empire

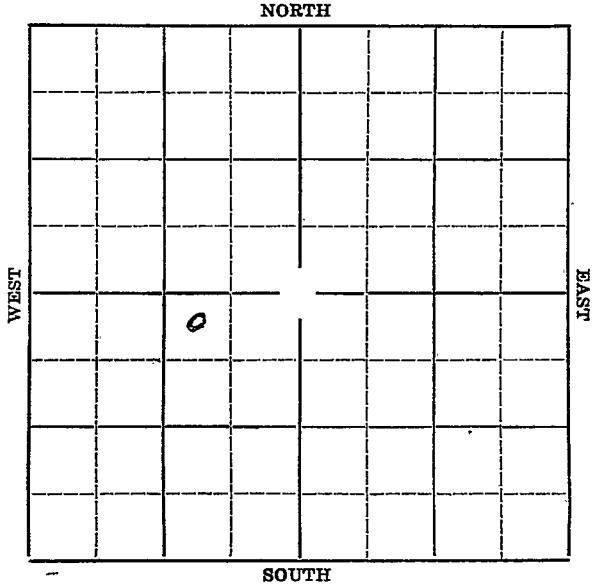

Map No. KANSAS Sec. 2 Twp. 14 R. 15W

Well No. #8 Crawford Farm
Empire Company


330' Ft. from N. Line

_____ Ft. from S. Line

990' Ft. from E. Line

_____ Ft. from W. Line

Elev. 1886

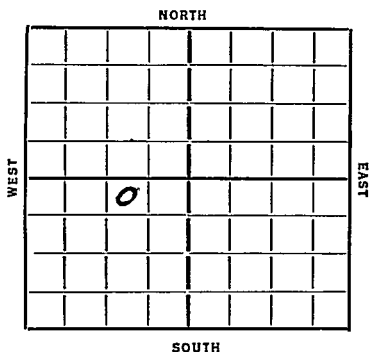

Date	REPORT
1936	
8/12	Rig on ground.
8/20	Rig.
8/27	Drlg. 390'.
9/3	Drlg. 1023'. anhydrate 913'. 12" @ 925'.
9/10	Drlg. 1665'.
9/18	Drlg. 2370'.
9/24	Topeka 2770'. Drlg. 2890'.
10/1	8" @ 3068'. Lansing 3063'. C.O.
10/8	Show oil 3086-90'. Show oil 3090-3108'. T.D. 3125'. 3000 gals acid. Notest.
10/15	Gorham sand 3115-16 $\frac{1}{2}$ '. 2800' of oil. 7" set 3315'.
10/21/36	Gorham 3315'. T.D. 3318'.
	3000 gallons of acid. Potential 1889 bbls of oil.
	COMPLETED

KANSAS

Map No. 72 Sec. 2 Twp. 14 R. 15WWell No. 8 CrawfordEmpire Company

Contractor

SECTION PLAT

	0		

330 Ft. from N. Line

_____ Ft. from S. Line

990 Ft. from E. Line

_____ Ft. from W. Line

FIRST REPORT

Location _____

Rig up _____

Drilling and Remarks:

R.O.G.

RECORD

Cased _____ in., _____ ft.

Sand _____

Gas _____

Oil _____

Total Depth _____

PRODUCTION

1st 24 hrs. Nat. _____

1st 24 hrs. after shot _____

Gas _____ Cu.-Ft.

Dry Hole _____

Abandoned _____

Date

AUG 12 1936

19

S. J. LEWIS Scout

KANSAS

Form 26—1M Bks. 2-29

Russell

Map No. 72 Sec. 2 Twp. 14 R. 15W

Well No. 5 Crawford

Empire Company

N Contractor

SECTION PLAT

330 Ft. from N. Line

_____ Ft. from S. Line

990 Ft. from E. Line

_____ Ft. from W. Line

	0		

COMPLETED

Location _____

Rig up _____

Drilling and Remarks:

*See kam 3315
3000 acid
Pd 1889*

RECORD

Cased _____ in., _____ ft.

Sand _____

Gas _____

Oil _____

Total Depth 3315

PRODUCTION

1st 24 hrs. Nat. _____

1st 24 hrs. after shot _____

Gas _____ Cu. Ft.

Dry Hole _____

Abandoned _____

Date

OCT 21 1936

19

S. J. LEWIS Scout