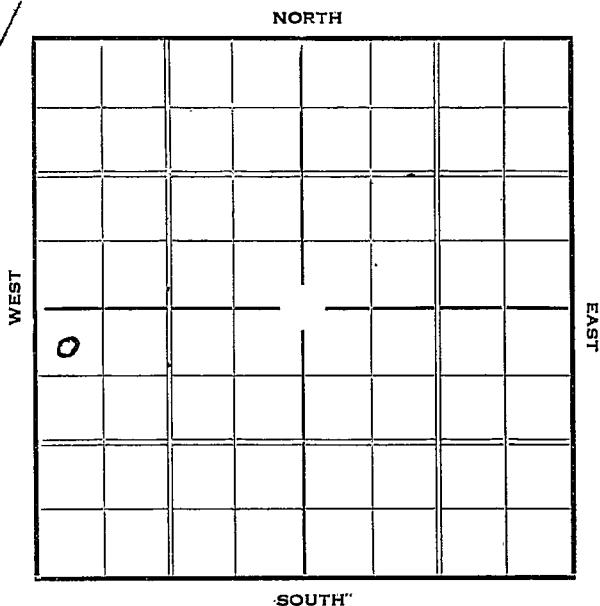
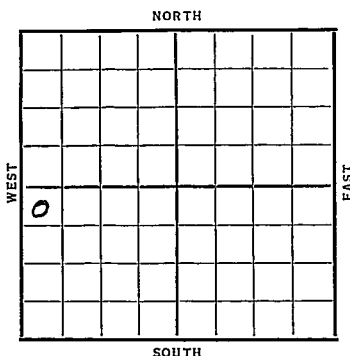


KANSAS

Section 2 Township 14 Range 15WWell Number 12 CrawfordCompany Empire

KANSAS

Russell

Sec. 2 Twp. 14 R. 15-WWell No. 12 Crawford FarmEmpire Company330 Ft. from N. Line Ft. from S. Line Ft. from E. Line330 Ft. from W. Line*Elev. 1869*

Date	REPORT
1936	
12/2	Building rig.
12/10	Spud.
12/17	15" @ 600'. Drlg. 840'.
12/24	Anhydrate 901'. 13" @ 910'.
	Drlg. 920'.
12/29	12" @ 2285'. Drlg. 2290'.
1937	
1/7	Topeka 2759' Oil 2870-77' Drlg.
1/14	Lansing 3043'. T. D. 3050'.
	Show oil. Underream 8".
1/21	K.C.L. 3037'. 8" @ 3045'.
	Pay 3049-59' T. D.
	Pot. 1215 natural.
1/27	Kansas City Lime 3037
	T. D. 3059
	2000 Acid
	Pump 1996
	COMPLETED

Map No. 72 Sec. 2 Twp. 14 R. 15W

Well No. 12 Crawford

Empire Company

Contractor

SECTION PLAT

0			

330 Ft. from N. Line

_____ Ft. from S. Line

_____ Ft. from E. Line

330 Ft. from W. ~~Line~~

FIRST REPORT

Location _____

Rig up _____

Drilling and Remarks:

Building rig

RECORD

Cased _____ in., _____ ft.

Sand _____

Gas _____

Oil _____

Total Depth _____

PRODUCTION

1st 24 hrs. Nat. _____

1st 24 hrs. after shot _____

Gas _____ Cu. Ft.

Dry Hole _____

Abandoned _____

Date

DEC 2 1936 19

S. J. LEWIS Scout

KANSAS

Map No. 72 Sec. 2. Twp. 14 R. 15WWell No. 12 CrawfordEmpire Company

Contractor

SECTION PLAT

330 Ft. from N. Line

_____ Ft. from S. Line

_____ Ft. from E. Line

330 Ft. from W. Line

COMPLETED

0			

Location _____

Rig up _____

Drilling and Remarks:

Kansas City Line30372000 acidPump. 1996

RECORD

Cased _____ in., _____ ft.

Sand _____

Gas _____

Oil _____

Total Depth 3059

PRODUCTION

1st 24 hrs. Nat. _____

1st 24 hrs. after shot _____

Gas _____ Cu. Ft.

Dry Hole _____

Abandoned _____

Date

JAN 27 1937 19

S. J. LEWIS

Scout