


Section " 2 Township 14 Range 15-W

Well Number #10 Crawford

Company Empire

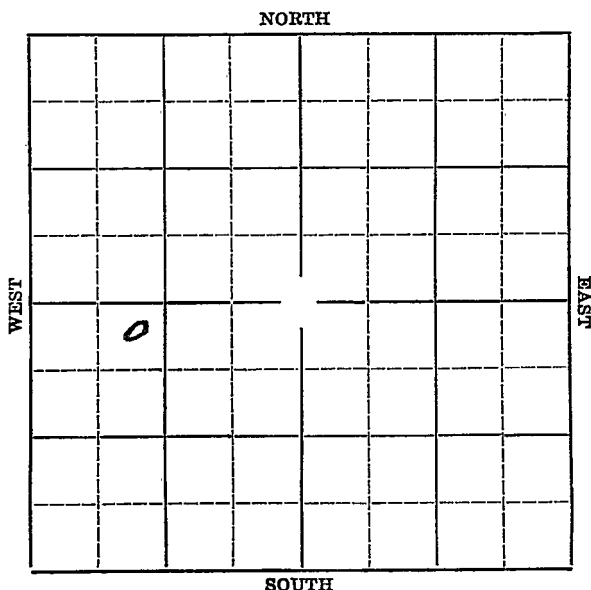

Sec. 2 Twp. 14 R. 15WWell No. #10 Crawford FarmEmpire Oil Company. Company330' Ft. from N. Line


Ft. from S. Line

Ft. from E. Line

990' Ft. from W. Line

Elev. 1874

NORTH

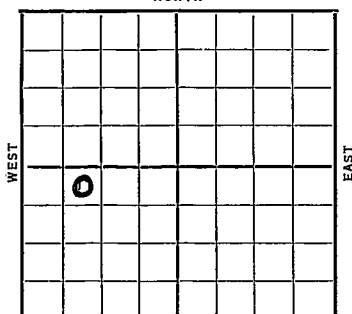

SOUTH

1936	REPORT
10/28	Rig.
11/6	15" @ 385 T. D. 597
	Underream 15"
11/12	10" @ 904 Drlg. 1726
11/19	Drlg. 2520'.
11/27	2770' fishing.
12/3	2840' fishing.
12/10	" " 12/17--12/24--
12/29	8" @ 3054'. Sil. 3058'.
	Clean out.
1937	
1/7	3210' clean out.
1/14	7" @ 3301' Gorham 3304'.
	Drlg. 3310'.
1/20	Gorham 3304'. T. D. 3308'.
	Pot. 728.
	COMPLETED

Map No. 72 Sec. 2 Twp. 14 R. 15

Well No. 10 Crawford

Empire Company

Contractor

SECTION PLAT

0			

330 Ft. from N. Line

_____ Ft. from S. Line

_____ Ft. from E. Line

990 Ft. from W. Line

FIRST REPORT

Location _____

Rig up _____

Drilling and Remarks:

Rig

RECORD

Cased _____ in., _____ ft.

Sand _____

Gas _____

Oil _____

Total Depth _____

PRODUCTION

1st 24 hrs. Nat. _____

1st 24 hrs. after shot _____

Gas _____ Cu. Ft.

Dry Hole _____

Abandoned _____

Date

OCT 2 1936

19

S. J. W. G.

Scout

Map No. 72 Sec. 2 Twp. 14 R. 15WWell No. 10. Crawford
Empire Company

Contractor

SECTION PLAT

0			

330 Ft. from N. Line Ft. from S. Line Ft. from E. Line990 Ft. from W. Line

COMPLETED

Location Rig up

Drilling and Remarks:

Gotham 3304P. Y 728

RECORD

Cased in., ft.Sand Gas Oil Total Depth 3308

PRODUCTION

1st 24 hrs. Nat. 1st 24 hrs. after shot Gas Cu. Ft.Dry Hole Abandoned

Date

JAN 20 1937 19

S. J. LEWIS Scout