

KANSAS


Russell

Form 51-5M-4-36-Palace

Section 2 Township 14 Range 15-W

Well Number Crawford
#7-Proffitt

Company Empire

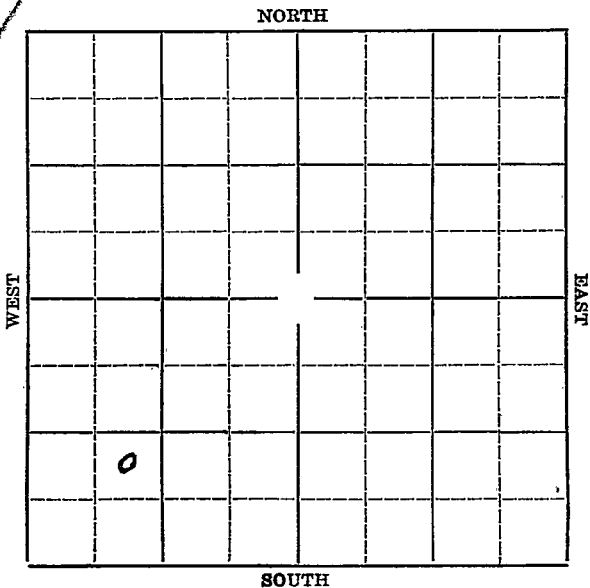

Map No. KANSAS Sec. 2 Twp. 14 R. 15W

Well No. ~~#1 Proffitt~~ #7 Crawford Farm

Empire Company


_____ Ft. from N. Line

990' Ft. from S. Line

_____ Ft. from E. Line

990' Ft. from W. Line

Elev. 1872

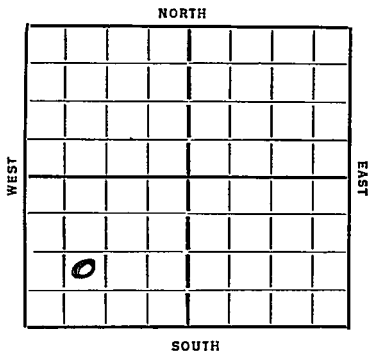

Date
1936

REPORT

8/5 Location

8/13 -- 8/20 --

8/27 20" @ 20'. Anhydrate 898'. 12" @ 910'. Drlg. 1310'.

9/3 Drlg. 2080'.

9/30/36 - Gorham 3282'.

T.D. 3293'.

Potential 1754 bbls of oil.

COMPLETED

KANSAS

Map No. 72 Sec. 2 Twp. 14 R. 15W

Well No. 7 Proffitt

Empire Company

Contractor

SECTION PLAT

0			

_____ Ft. from N. Line

990 Ft. from S. Line

_____ Ft. from E. Line

980 Ft. from W. Line

FIRST REPORT

Location ✓

Rig up _____

Drilling and Remarks:

RECORD

Cased _____ in., _____ ft.

Sand _____

Gas _____

Oil _____

Total Depth _____

PRODUCTION

1st 24 hrs. Nat. _____

1st 24 hrs. after shot _____

Gas _____ Cu. Ft.

Dry Hole _____

Abandoned _____

Date

AUG 5 1936₁₉

S. J. LEWIS Scout

KANSAS

Map No. 72 Sec. 2 Twp. 14 R. 15W

Well No. 7 Crawford

Empire Company

Contractor

SECTION PLAT

_____ Ft. from N. Line

990 Ft. from S. Line

_____ Ft. from E. Line

990 Ft. from W. Line

o			

CORRECTION

Location _____

Rig up _____

Drilling and Remarks:

*Reported
as No 7 Payne*

RECORD

Cased _____ in., _____ ft.

Sand _____

Gas _____

Oil _____

Total Depth _____

PRODUCTION

1st 24 hrs. Nat. _____

1st 24 hrs. after shot _____

Gas _____ Cu. Ft.

Dry Hole _____

Abandoned _____

Date

AUG 19 1936

S. J. LEWIS

Scout

KANSAS

Map No. 72 Sec. 2 Twp. 14 R. 15W

Well No. 7 Crawford

Empire Company

Contractor

SECTION PLAT

_____ Ft. from N. Line

990 Ft. from S. Line

_____ Ft. from E. Line

990 Ft. from W. Line

COMPLETED

Location _____

Rig up _____

Drilling and Remarks:

Goekam 3289

PO 1754

RECORD

Cased _____ in., _____ ft.

Sand _____

Gas _____

Oil _____

Total Depth 3293

PRODUCTION

1st 24 hrs. Nat. _____

1st 24 hrs. after shot _____

Gas _____ Cu. Ft.

Dry Hole _____

Abandoned _____

Date

SEP 30 1936 19

S. J. LEWIS

Scout