


Section 2 Township 14 Range 15-W

Well Number 5-Crawford

Company Empire

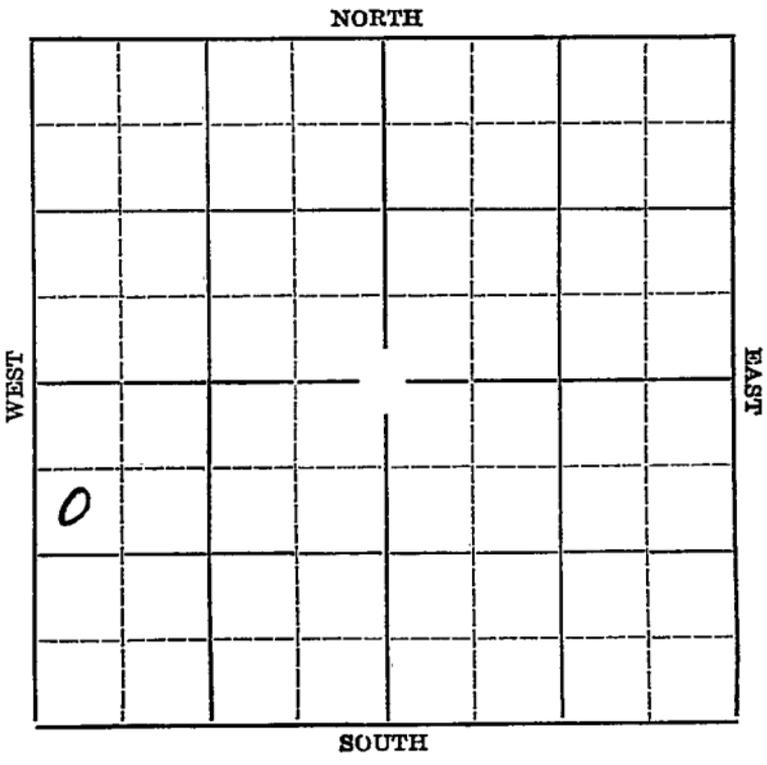

Map No. _____ Sec. 2 Twp. 14 R. 15W

Well No. #5 Crawford Farm _____

Empire Company _____


990' Ft. from N. Line

_____ Ft. from S. Line

_____ Ft. from E. Line

330' Ft. from W. Line

Elev. 1865

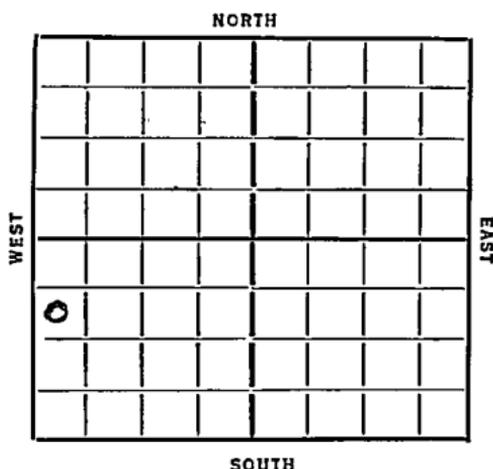

Date	REPORT
1936	
4/29	Location
5/7	Building rig.
5/14	Rigging up.
5/21	Drlg. 625'.
5/28	Drlg. 1835'.
6/4	Drlg. 2121'.
6/11	2500' U.R. 10".
6/18	Fishing.
6/25	Topeka 2428'. Drlg. 2775'.
7/2	Lansing 3036'. Show oil 3048-51'.
	Free oil 3058-64'. Drlg.
7/9	1 BW 3068'. Plug back.
7/16	Shut down.
7/23	Gorham 3288'. Under ream 6".
7/30	--
8/5/36	Gorham sand 3288'.
	T.D. 3297'.
	Pot. 1098-bbls natural.
	COMPLETED

Map No. 72 Sec. 2 Twp. 14 R. 15W

Well No. 5 Crawford

Empire Company

Contractor

SECTION PLAT

990 Ft. from N. Line

..... Ft. from S. Line

..... Ft. from E. Line

330 Ft. from W. Line

FIRST REPORT

Location ✓

Rig up

Drilling and Remarks:

RECORD

Cased..... in., ft.

Sand.....

Gas.....

Oil.....

Total Depth.....

PRODUCTION

1st 24 hrs. Nat.....

1st 24 hrs. after shot.....

Gas..... Cu. Ft.

Dry Hole.....

Abandoned.....

Date

APR 29 1936

192.....

S. J. LEWIS

Scout

Russell

KANSAS

Map No. 72 Sec. 2 Twp. 14 R. 15W

Well No. 5 Crawford

Empire Company

Contractor

SECTION PLAT

0			

990 Ft. from N. Line

_____ Ft. from S. Line

_____ Ft. from E. Line

330 Ft. from W. Line

COMPLETED

Location _____

Rig up _____

Drilling and Remarks:

*Got base sand
3288.*

*Prod 1098
Nat.*

RECORD

Cased _____ in., _____ ft.

Sand _____

Gas _____

Oil _____

Total Depth 3297

PRODUCTION

1st 24 hrs. Nat. _____

1st 24 hrs. after shot _____

Gas _____ Cu. Ft.

Dry Hole _____

Abandoned _____

Date

AUG 5 1936 19

S. J. LEWIS

Scout