


RUSSELL

Form 51-5M-3-35-Mid-West

Map No. **KANSAS** Sec. **2** Twp. **14** R. **15-W**

Well No. **3-Crawford** Farm
Empire Oil Company

NORTH

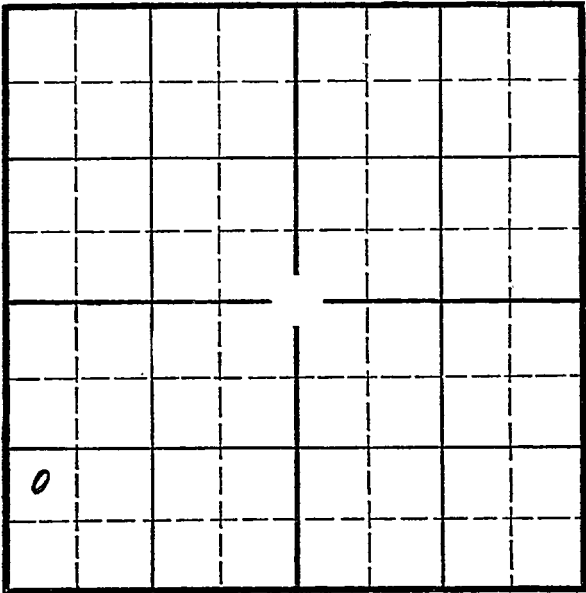

SOUTH

Location
 Drilling Remarks

Rig Up
 Drilling Remarks

RECORD

Cased in. ft.

Sand

Gas

Oil

Total Depth

PRODUCTION

1st 24 hrs. Nat.

1st 24 hrs. after shot

Gas cu. ft.

Dry Hole

Abandoned

Map No. 15 Sec. 2 Twp. 19 R. 15
Well No. 3- Crawford Farm
Empire Oil Company
NORTH


Ft. from N. Line

990 Ft. from S. Line

Ft. from E. Line

330 Ft. from W. Line

Elev. 1864

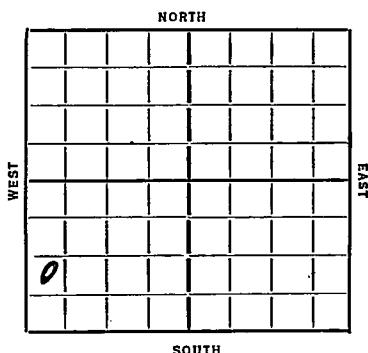

Date 1956

REPORT

<u>Date</u>	<u>Location</u>
3/11	

3/20 Rig.

3/27 Spud.

4/2 15"-591' T. Anhy 888' 12"- 900'
DrLg. 925'

4/10 Drlg. 2120'

4/16 Drlg. 2815'

4/23 Top Oswald 3034' Top Sil. 3284'
Dr] g.

4/30	T.D. 3286' Pump 550 bbls in 20 hrs
------	------------------------------------

5/6/36- Sil 3284! T.D..3286!
755 hbls natural.

~~COMPLETED~~

Map No. 72 Sec. 2 Twp. 14 R. 15Well No. 3-CrawfordEmpire oil Company

Contractor

FIRST REPORTS

Ft. from N. Line

990 Ft. from S. Line

Ft. from E. Line

330 Ft. from W. Line

SECTION PLAT

0			

Location ✓

Rig up

Drilling and Remarks:

RECORD

Cased in., ft.

Sand

Gas

Oil

Total Depth

PRODUCTION

1st 24 hrs. Nat.

1st 24 hrs. after shot

Gas Cu. Ft.

Dry Hole

Abandoned

Date

ORVAL MANNSCHRECK

3-11-36 192 Scout

KANSAS

Map No. 72 Sec. 2 Twp. 14 R. 15 NWell No. 3 CrawfordEmpire Company

Contractor

SECTION PLAT

Ft. from N. Line

990 Ft. from S. Line

Ft. from E. Line

330 Ft. from W. Line

COMPLETED

0			

Location

Rig up

Drilling and Remarks:

Sil 3284755 8 1/2 gal

RECORD

Cased _____ in., _____ ft.

Sand _____

Gas _____

Oil _____

Total Depth 3286

PRODUCTION

1st 24 hrs. Nat. _____

1st 24 hrs. after shot _____

Gas _____ Cu. Ft.

Dry Hole _____

Abandoned _____

Date

MAY 6 1936

S. J. LEWIS

Scout