


Map No. KANSAS Sec. 2 Twp. 14 R. 15W

Well No. #4 Crawford Farm

Empire O & R Company

NORTH

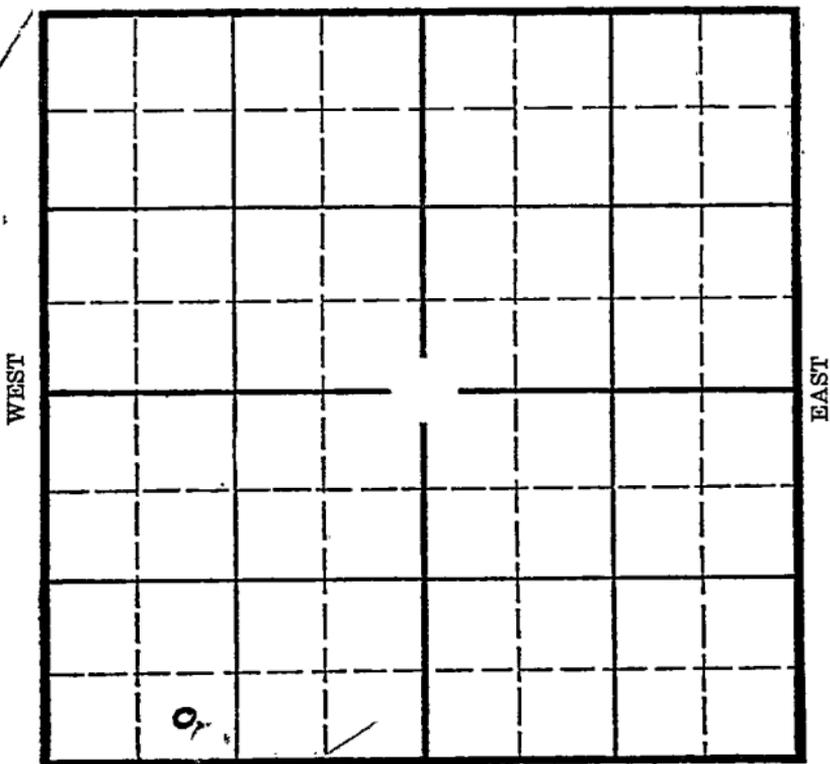

Location \_\_\_\_\_

Drilling Remarks \_\_\_\_\_  
\_\_\_\_\_  
\_\_\_\_\_  
Rig Up \_\_\_\_\_

Drilling Remarks \_\_\_\_\_  
\_\_\_\_\_  
\_\_\_\_\_  
RECORD

Cased \_\_\_\_\_ in. \_\_\_\_\_ ft.

Sand \_\_\_\_\_

Gas \_\_\_\_\_

Oil \_\_\_\_\_

Total Depth \_\_\_\_\_

PRODUCTION

1st 24 hrs. Nat. \_\_\_\_\_

1st 24 hrs. after shot \_\_\_\_\_

Gas \_\_\_\_\_ cu. ft. \_\_\_\_\_

Dry Hole \_\_\_\_\_

Abandoned \_\_\_\_\_

**KANSAS**

Map No. \_\_\_\_\_ Sec. 2 Twp. 14 R. 15-W

Well No. 4-Crawford Farm \_\_\_\_\_


Empire O & Refg. Company \_\_\_\_\_

\_\_\_\_\_ Ft. from N. Line

330 Ft. from S. Line

\_\_\_\_\_ Ft. from E. Line

990 Ft. from W. Line

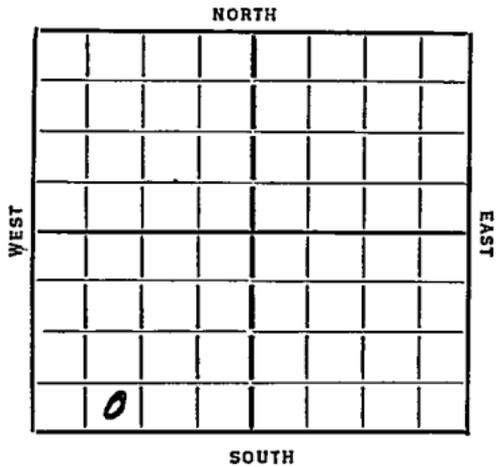

Elev. 1876

Date  
1936

REPORT

4/8 B.R.

4/16 Rigging up.

4/23 Spud.

4/30 12" @ 960'.

5/7 S.O. 1730'. Drlg. 1835'.

5/14 Drlg. 2420';

5/21 Drlg. 2575'.

5/28 Drlg. 2880'.

6/4 Oswald 3027'. S.O. 3070'. S.O. & W  
3145'. ~~3277'~~ <sup>T.D. 3277'</sup> "Run 6"

6/11 Gorham 3298'. T.D. 3300'. 2700' of  
oil in 6 hours.

6/17/36-Gorham 3298'.

T.D. 3000'.

Potential 757 bbls oil

COMPLETED

KANSAS

Map No. 72 Sec. 2 Twp. 14 R. 15W

Well No. 4 Crawford

Empire Oil & Ref. Company

Contractor

SECTION PLAT


..... Ft. from N. Line

930 Ft. from S. Line

..... Ft. from E. Line

990 Ft. from W. Line

FIRST REPORT

Location.....

Rig up.....

Drilling and Remarks:

*B.R.*

RECORD

Cased..... in., ..... ft.

Sand.....

Gas.....

Oil.....

Total Depth.....

PRODUCTION

1st 24 hrs. Nat.....

1st 24 hrs. after shot.....

Gas..... Cu. Ft.

Dry Hole.....

Abandoned.....

Date

4/5/36 192.....

S. J. LEWIS

Scout

*Russell*

Map No. 72 Sec. 2 Twp. 14 R. 15W

Well No. 4 Crawford

Empire Company

Contractor

**SECTION PLAT**


\_\_\_\_\_ Ft. from N. Line

320 Ft. from S. Line

\_\_\_\_\_ Ft. from E. Line

990 Ft. from W. Line

**COMPLETED**

Location \_\_\_\_\_

Rig up \_\_\_\_\_

Drilling and Remarks:

*Got kam 3298*

*P.O. 757 1/2*

**RECORD**

Cased \_\_\_\_\_ in., \_\_\_\_\_ ft.

Sand \_\_\_\_\_

Gas

Oil

Total Depth 3000

**PRODUCTION**

1st 24 hrs. Nat. \_\_\_\_\_

1st 24 hrs. after shot \_\_\_\_\_

Gas \_\_\_\_\_ Cu. Ft.

Dry Hole \_\_\_\_\_

Abandoned \_\_\_\_\_

Date

JUN 17 1936

19

S. J. LEWIS

Scout