


Map No. **KANSAS** Sec. **2** Twp. **14** R. **15^W**
 Well No. **2 Crawford** Farm
Empire Company

NORTH

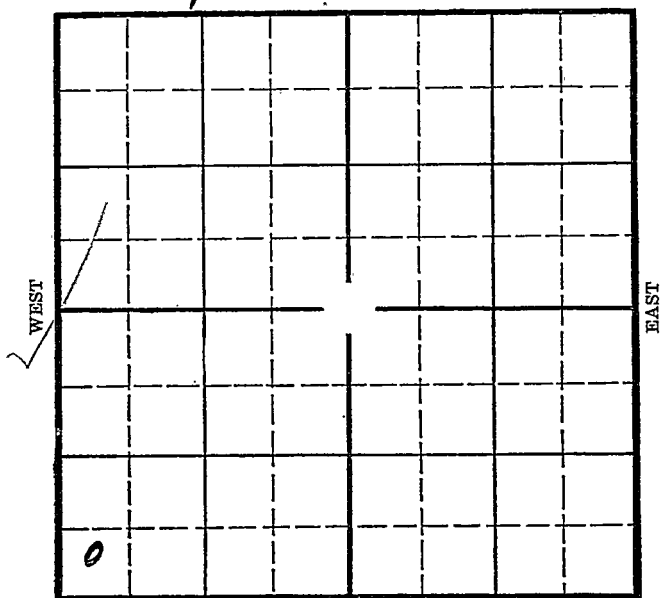

SOUTH

Location _____

Drilling Remarks _____

Rig Up _____

Drilling Remarks _____

RECORD

Cased _____ in. _____ ft.

Sand _____

Gas _____

Oil _____

Total Depth _____

PRODUCTION

1st 24 hrs. Nat. _____

1st 24 hrs. after shot _____

Gas _____ cu. ft. _____

Dry Hole _____

Abandoned _____

KANSAS

Map No. 72 Sec. 2 Twp. 14 R. 15 W

Well No. 2 - Crawford

Empire Company

Contractor

FIRST REPORTS

.....Ft. from N. Line

330 Ft. from S. Line

.....Ft. from E. Line

330 Ft. from W. Line

SECTION PLAT

0			

Location.....

Rig up.....

Drilling and Remarks:

BR

RECORD

Cased.....in.,ft.

Sand.....

Gas.....

Oil.....

Total Depth.....

PRODUCTION

1st 24 hrs. Nat.....

1st 24 hrs. after shot.....

Gas.....Cu. Ft.

Dry Hole.....

Abandoned.....

Date

ORVAL MANNSCHRECK

1-15-26 192.....Scout

Map No. 72 Sec. 2 Twp. 14 R. 15W

Well No. 2 - Crawford

Empire Company

Contractor

COMPLETED

SECTION PLAT

Ft. from N. Line

330 Ft. from S. Line

Ft. from E. Line

330 Ft. from W. Line

0			

Location

Rig up

Drilling and Remarks:

1463 Bbls

RECORD

Cased in ft.

Sand Gorham 3292

Gas

Oil

Total Depth 3293

PRODUCTION

1st 24 hrs. Nat.

1st 24 hrs. after shot

Gas Cu. Ft.

Dry Hole

Abandoned

Date

MAR 18 1936

ORVAL MANNSCHRECK

192 Scout