

Map No.

KANSAS

Sec.

2

Twp.

14

R.

Russell 15w

Well No.

1- Crawford
Empire Oil

Farm

Company

NORTH

WEST

EAST

SOUTH

Location

Drilling Remarks

Rig Up

Drilling Remarks

RECORD

Cased _____ in. _____ ft.

Sand _____

Gas _____

Oil _____

Total Depth _____

PRODUCTION

1st 24 hrs. Nat. _____

1st 24 hrs. after shot _____

Gas _____ cu. ft. _____

Dry Hole _____

Abandoned _____

Russell


Map No. _____ Sec. 2 Twp. 14 R. 15W
Well No. 1- Crawford Farm _____
Empire Oil Company _____

330 Ft. from N. Line

_____ Ft. from S. Line

330 Ft. from E. Line

_____ Ft. from W. Line

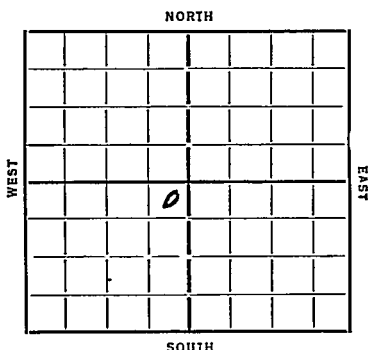

Elev. 1891

REPORT

Date	Location	
5/22	Location	
5/29	Rig	
6/6	Rgn	
6/13	Spud	20" 20
6/20	Blg 800	15" 435
6/28	" 1200	
7/3	" 1420	12" 920
7/11	" 2275	
7/18	" 2605	10" 527
8/8	Drill 3060	
	58' 6" line 3050	
8/15	3108 T7 250' oil 1000 acid	
8/21	Drill 3060	
	T7 3108	
	1000 acid	
	867 Bbls.	

COMPLETED

Map No. 72 Sec. 2 Twp. 14 R. 15 ✓Well No. 1-CrawfordEmpire oil Company

Contractor

SECTION PLAT

FIRST REPORTS

330 Ft. from N. Line

Ft. from S. Line

330 Ft. from E. Line

Ft. from W. Line

		0	

Location ✓

Rig up

Drilling and Remarks:

RECORD

Cased _____ in., _____ ft.

Sand _____

Gas _____

Oil _____

Total Depth _____

PRODUCTION

1st 24 hrs. Nat. _____

1st 24 hrs. after shot _____

Gas _____ Cu. Ft.

Dry Hole _____

Abandoned _____

Date

5-22-35 192ORVAL MANNSCHRECK
Scout

KANSAS

Map No. 72 Sec. 2 Twp. 14 R. 15WWell No. 1-CrawfordEmpire Oil

Company

Contractor

~~COMPLETED~~

SECTION PLAT

330 Ft. from N. Line

Ft. from S. Line

330 Ft. from E. Line

Ft. from W. Line

	0		

Location

Rig up

Drilling and Remarks:

1000 and867 bbls

RECORD

Cased in ft.

Sand Crawford 3060

Gas

Oil

Total Depth 3108

PRODUCTION

1st 24 hrs. Nat.

1st 24 hrs. after shot

Gas Cu. Ft.

Dry Hole

Abandoned

Date

8-21-35 192~~COMPLETED~~

Scout