STATE OF KANSAS
STATE CORPORATION COMMISSION

Form CP-4

Give All Information Completely
Make Required Affidavit
Mail or Deliver Report to:
Conservation Division
State Corporation Commission
212 No. Market
Wichita, Kansas

WELL PLUGGING RECORD

NORTH

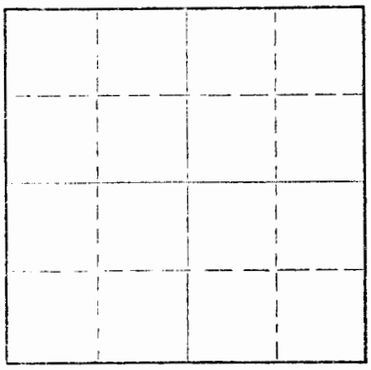

Locate well correctly on above Section Plat

Ellis County. Sec. 8 Twp. 14 Rge. 20 (E) (W)

Location as "NE/CNW¼SW¼" or footage from lines Approx. 150' N & 95' E of SE NW NW

Lease Owner Rupe, Stephenson, Ash & Brooks

Lease Name Younger Well No. 1

Office Address Suite 925, 200 West Douglas, Wichita, Kansas

Character of Well (completed as Oil, Gas or Dry Hole) Dry Hole

Date well completed March 26 19 71

Application for plugging filed March 26 19 71

Application for plugging approved March 26 19 71

Plugging commenced 2:15 P.M., March 26 19 71

Plugging completed 6:45 P.M., March 26 19 71

Reason for abandonment of well or producing formation

If a producing well is abandoned, date of last production 19

Was permission obtained from the Conservation Division or its agents before plugging was commenced? Yes

Name of Conservation Agent who supervised plugging of this well Leo Massey, P. O. Box 582, Hays, Kansas 67601

Producing formation Depth to top Bottom Total Depth of Well 3847½ Feet

Show depth and thickness of all water, oil and gas formations.

OIL, GAS OR WATER RECORDS — CASING RECORD

FORMATION	CONTENT	FROM	TO	SIZE	PUT IN	PULLED OUT

Describe in detail the manner in which the well was plugged, indicating where the mud fluid was placed and the method or methods used in introducing it into the hole. If cement or other plugs were used, state the character of same and depth placed, from feet to feet for each plug set.

Filled hole with heavy mud. Pushed plug to 660 feet, dumped in 70 sx. cement. Set a plug at 210 feet with 20 sx. cement. Set plug at 40 feet, dumped in 10 sx. cement to top of hole. Job completed at 6:45 P.M. 3-26-71.

(If additional description is necessary, use BACK of this sheet)

Name of Plugging Contractor Sun Oilwell Cementing, Inc.

Address P. O. Box 169, Great Bend, Kansas 67530

STATE OF Kansas, COUNTY OF Sedgwick, ss.

Larry G. Stephenson, (employee of owner) or (owner or operator) of the above-described well, being first duly sworn on oath, says: That I have knowledge of the facts, statements, and matters herein contained and the log of the above-described well as filed and that the same are true and correct. So help me God.

(Signature) Larry G. Stephenson

360 Sutton Place, Wichita, Kansas
(Address)

SUBSCRIBED AND SWORN TO before me this 12th day of April, 19 71

Phyllis Gillen, *Notary Public.*

My commission expires August 30, 1973