


STATE OF KANSAS
 STATE CORPORATION COMMISSION
 CONSERVATION DIVISION
 P. O. BOX 17027
 WICHITA, KANSAS 67217

WELL PLUGGING RECORD

REC'D AUG 14 1975
 FORM CP-4

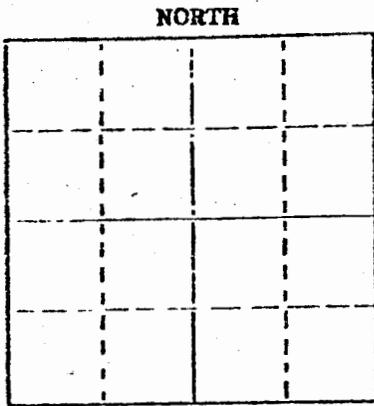

Locate well correctly on above Section Plat

Ellis County, Sec. 16 Twp 14S Rge. 20W (E) (W)
 Location as "NE/CNWSW" or footage from lines NE NE SW
 Lease Owner Mr. Larry G. Stephenson
 Lease Name Seibel "A" Well No. 1
 Office Address 340 Farm Credit Bank Bldg., Wichita, KS 67202
 Character of Well (completed as Oil, Gas or Dry Hole) D & A
 Date well completed October 24 19 74
 Application for plugging filed October 24 19 74
 Application for plugging approved October 24 19 74
 Plugging commenced October 24 19 74
 Plugging completed October 24 19 74
 Reason for abandonment of well or producing formation D & A

If a producing well is abandoned, date of last production 19
 Was permission obtained from the Conservation Division or its agents before plugging was commenced? Yes

Name of Conservation Agent who supervised plugging of this well Mr. Leo F. Massey
 Producing formation _____ Depth to top _____ Bottom _____ Total Depth of Well 3843' Feet
 Show depth and thickness of all water, oil and gas formations.

OIL, GAS OR WATER RECORDS

CASING RECORD

FORMATION	CONTENT	FROM	TO	SIZE	PUT IN	PULLED OUT
				8-5/8"	270'	-0-

Describe in detail the manner in which the well was plugged, indicating where the mud fluid was placed and the method or methods used in introducing it into the hole. If cement or other plugs were used, state the character of same and depth placed, from _____ feet to _____ feet for each plug set.

Plug @ 660' w/70 sx.
 Spotted 20 sx. @ 240'
 Plug-bridge @ 40' w/10 sx.

(If additional description is necessary, use BACK of this sheet)
 Name of Plugging Contractor Red Tiger Drilling Company
 Address 1720 Wichita Plaza, Wichita, Kansas 67202

STATE OF Kansas COUNTY OF Sedgwick ss.
 Linda H. Dickens (employee of owner) or (owner or operator) of the above-described well, being first duly sworn on oath, says: That I have knowledge of the facts, statements, and matters herein contained and the log of the above-described well as filed and that the same are true and correct. So help me God.

(Signature) Linda H. Dickens
 1720 Wichita Plaza, Wichita, Kansas 67202
 (Address)

Subscribed and sworn to before me this 29th day of October, 19 74

My commission expires December 28, 1977

D'Ann Drennan
 Notary Public

