


WELL PLUGGING RECORD

Give All Information Completely
Make Required Affidavit
Mail or Deliver Report to:
Conservation Division
State Corporation Commission
212 No. Market
Wichita, Kansas

Ellis County, Sec. 11 Twp. 14 Rge. 20 (E) W (W)
Location as "NE/CNW&SW" or footage from lines CS/2 NW NW
Lease Owner Spector Pipe and Supply Inc.
Lease Name Josephine Well No. 3
Office Address Russell, Kansas
Character of Well (completed as Oil, Gas or Dry Hole) oil
Date well completed 3-16-46 19
Application for plugging filed July 26, 1967 19
Application for plugging approved July 27, 1967 19
Plugging commenced August 30, 1967 19
Plugging completed September 6, 1967 19
Reason for abandonment of well or producing formation failure to produce profitably

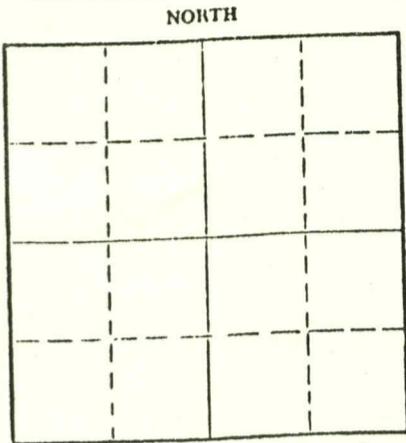

Locate well correctly on above Section Plat

If a producing well is abandoned, date of last production _____ 19
Was permission obtained from the Conservation Division or its agents before plugging was commenced? Yes

Name of Conservation Agent who supervised plugging of this well Leo Massey
Producing formation Arbuckle Depth to top 3832 Bottom 3833 ft Total Depth of Well 3844 feet
Show depth and thickness of all water, oil and gas formations.

OIL, GAS OR WATER RECORDS CASING RECORD

| FORMATION | CONTENT | FROM | TO | SIZE | PUT IN | PULLED OUT |
|-----------|---------|------|----|-----------|----------|------------|
| | | | | 8 5/8" OD | 1526 ft. | none |
| | | | | 5 1/2" OD | 3833 ft. | 2702 ft. |
| | | | | | | |
| | | | | | | |
| | | | | | | |
| | | | | | | |

Describe in detail the manner in which the well was plugged, indicating where the mud fluid was placed and the method or methods used in introducing it into the hole. If cement or other plugs were used, state the character of same and depth placed, from _____ feet to _____ feet for each plug set.

Plugged back with sand to 3700 feet and dumped 5 sacks of cement.
Mudded hole to 570 feet, set 20-foot Rock Bridge and finished filling hole with cement.

SEP 15 1967

(If additional description is necessary, use BACK of this sheet)

Name of Plugging Contractor Lynch Casing Pulling Company 457
Address R.F.D. 4, Great Bend, Kansas

STATE OF Kansas, COUNTY OF Russell, ss.

Spector Pipe & Supply, Inc. (employee of owner) or (owner or operator) of the above-described well, being first duly sworn on oath, says: That I have knowledge of the facts, statements, and matters herein contained and the log of the above-described well as filed and that the same are true and correct. So help me God.

(Signature) [Signature]
(Address) Russell, Kansas

SUBSCRIBED AND SWORN TO before me this 11th day of September, 1967

Wilma M. Lundahl
Notary Public.
My commission expires May 21, 1971