

KANSAS

FORM 51 5M 1-42 PETROL

Russell

Section 20 Township 14 Range 14-W

Well No. #1 Brandenburg

Company Co-op

NORTH

WEST

EAST

SOUTH

14

0


KANSAS

Sec. 20 Twp. 14 R. 14-W

Well No. #1 Brandenburg Farm

Co-op Company

NORTH

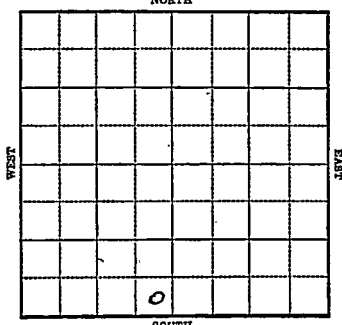

SOUTH

Ft. from N. Line

330 Ft. from S. Line

330 Ft. from E. Line

Ft. from W. Line

1944

R E P O R T

1-19 Surface hole
Rig up 1-17-44

1/26 Anhy 833
8" @ 845
WOC.

2/2 Drlg. 2526

2/8 Topeka 2720
Lans 3009-65 TD SO
5" @ 3065 Rust

2/15 Gorham 3266
TD 3271 $\frac{1}{2}$ -2700' oil

2/23 Swb 32 oil in 4 hrs.

3/1 " 2 " "

3/8 5" @ 3265
Lans 3009 Gorham 3266'
TD 3271 $\frac{1}{2}$
Pump 500 Pot.
Gravity 37
COMPLETED

~~KANSAS~~
 Map No. _____ Sec. 20 Twp. 14 R. 14W
 Well No. 1 Brandenberg

Co-op


Company

FIRST REPORT

Contractor

SE SW

SECTION PLAT

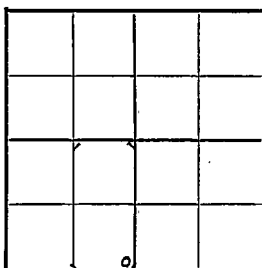

_____ Ft. from N. Line

330 Ft. from S. Line330 Ft. from E. Line

_____ Ft. from W. Line

Hall-Gurney Pool

Location _____

Rig up 1-17-44

Drilling and Remarks:

Surface Hole

RECORD

Cased _____ in., _____ ft.

Sand _____

Gas _____

Oil _____

Total Depth _____

PRODUCTION

1st 24 hrs. Nat. _____

1st 24 hrs. after shot _____

Gas _____ Cu. Ft.

Dry Hole _____

Abandoned _____

Date

JAN 19 1944 19 S. J. LEWIS Scout

KANSAS

Map No. 72 Sec. 20 Twp. 14 R. 14WWell No. 1 Brandenburg

Co-op


Company

COMPLETED

Contractor

SE SW

SECTION PLAT

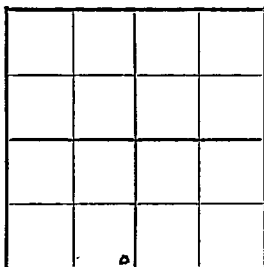

Ft. from N. Line

330

Ft. from S. Line

330

Ft. from E. Line

Ft. from W. Line

Williamson Pool

Location

Rig up

Drilling and Remarks:


RECORD

Cased _____ in., _____ ft.

Sand _____

Gas _____

Oil _____

Total Depth 3271 1/2

PRODUCTION

1st 24 hrs. Nat. _____

1st 24 hrs. after shot _____

Gas _____ Cu. Ft.

Dry Hole _____

Abandoned _____

Date

MAR 8 1944 19

S. J. LEWIS Scout