

KANSAS


Russell

FORM 51 5M PETROL

Section 20 Township 14 Range 14 ~~11~~

Well No. #3 Brandenburg

Company Co-op

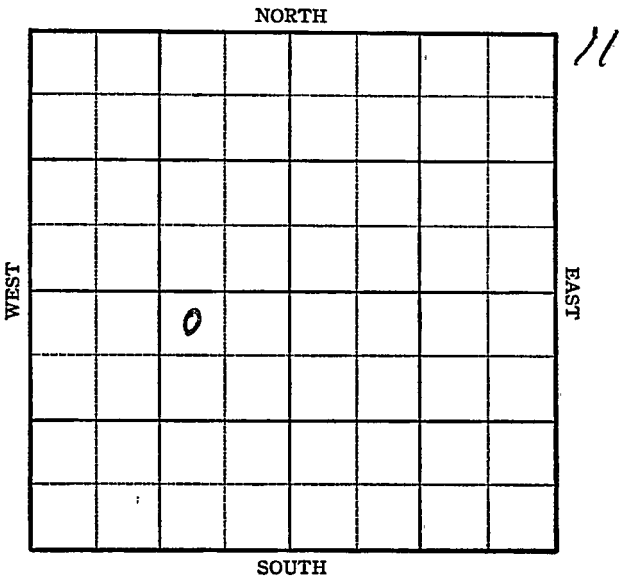


KANSAS

Russell County

Sec. 20 Twp. 14N R. 14WWell No. #3 Brandenburg FarmCo-op Company330 Ft. from N. Line Ft. from S. Line990 Ft. from E. Line Ft. from W. Line

NW NE SW

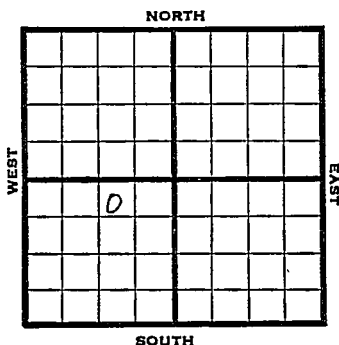

1945 Elev. 1857' REPORT

12/28	Location
1946	"
1/10	"
1/17	Anhy 840' 10" - 854' WOC.
1/24	Drlg. 2338'
1/31	Lans. 2992' T.D. 2996'
	7" - 2996' RUST.
2/7	" " "
2/14	T.D. 3088' SSO 10,000 acid.
2/21	" " "
2/28	" " "
3/7	" " "
3/13	" " "
3/21	" " "
3/28	" " "
4/4	No test
4/10	" "
4/16	" "
4/23	" "
5/1	Lans 2992
	7" @ 2996
	TD 3088'
	10,000 acid.
	Pump 60 Pot.
	Grav. 32.7

COMPLETED

KANSAS Kansas Pool Name _____
 Map No. K-72 Sec. 20 Twp. 14 R. 14W

Well No. 3 Brandenburg

Co-op _____ Company _____

FIRST REPORT Contractor _____

NW NE SW

SECTION PLAT

330 Ft. from N. Line

_____ Ft. from S. Line

990 Ft. from E. Line

_____ Ft. from W. Line

	o		

Russell County

Location X

Rig up _____

Drilling and Remarks:

1

RECORD

Cased _____ in. _____ ft.

Sand _____

Gas _____

Oil _____

Total Depth _____

PRODUCTION

1st 24 hrs. Nat. _____

1st 24 hrs. after shot _____

Gas _____ Cu. Ft.

Dry Hole _____

Abandoned _____

Date

DEC 28 1945 19

S. J. LEWIS Scout

Kansas Pool Name Big Creek

KANSAS
 Map No. 72 Sec. 20 Twp. 14 R. 14W

Well No. 3 Brandenburg

Co-op

Company

COMPLETED

Contractor

NW NE SW

330 Ft. from N. Line Ft. from S. Line990 Ft. from E. Line Ft. from W. Line

E11857
 SECTION PLAT

	0		

Russell County

Location

Rig up

Drilling and Remarks:

Louis 2992
7" 2996
10000 acid

Pump 60 Bx.

32 1/2 gr

RECORD

Cased in., ft.Sand Gas Oil Total Depth 3088

PRODUCTION

1st 24 hrs. Nat. 1st 24 hrs. after shot Gas Cu. Ft.Dry Hole Abandoned

Date

MAY 1 1946

19

S. J. LEWIS

Scout