
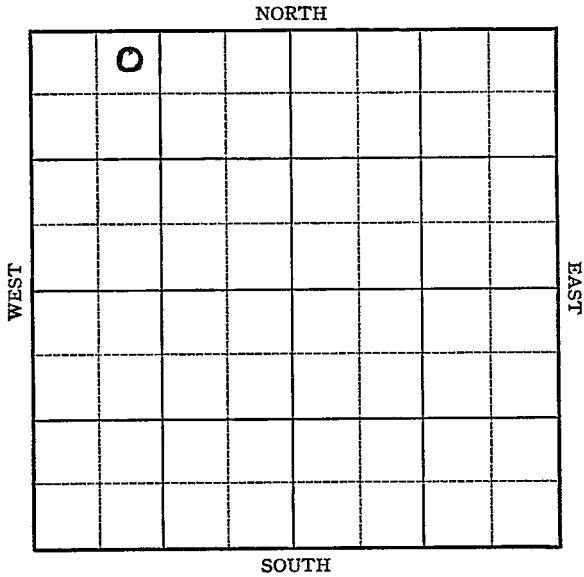


Section 20 Township 14 Range 14-WWell No. 2 - BrandenburgCompany Texas

Sec. 20 Twp. 14 R. 14-WWell No. #2 Brandenburg. FarmTexas Company330 Ft. from N. Line Ft. from S. Line Ft. from E. Line990 Ft. from W. Line

Elev. 1853

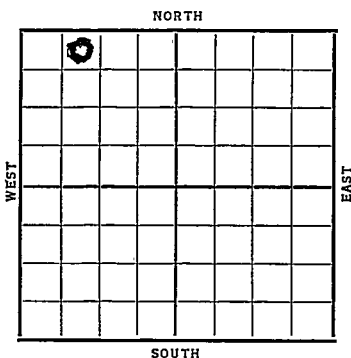

Date	REPORT
1937	
6/2	Cellar
6/11	R. R.
6/19	Drlg. 350'.
6/25	12" @ 360'. Drlg. 2000'.
7/2	Drlg. 2975'.
7/9	Lansing 3000'. 7" @ 3001'.
	RUST.
7/14	7" @ 3001'.
	Lans. 3000'.
	T.D. 3050'.
	2000' oil in 12 hrs.
	2000 acid.
	Pot. 640 bbls.
	COMPLETED

Russell **KANSAS**Map No. 72 Sec. 20 Twp. 14 R. 14 ^WWell No. 2- BrandenburgTexas Company

Contractor

FIRST REPORT**SECTION PLAT**

0			

330 Ft. from N. Line

_____ Ft. from S. Line

_____ Ft. from E. Line

990 Ft. from W. Line

Location _____

Rig up _____

Drilling and Remarks:

*Cellar***RECORD**

Cased _____ in., _____ ft.

Sand _____

Gas _____

Oil _____

Total Depth _____

PRODUCTION

1st 24 hrs. Nat. _____

1st 24 hrs. after shot _____

Gas _____ Cu. Ft.

Dry Hole _____

Abandoned _____

Date

JUN 2 1937

19

H. D. Hatfield

Scout

Russell KANSAS

Map No. _____ Sec. 20 Twp. 14 R. 14^WWell No. 2-BrandenburgTexas Company

Contractor _____

COMPLETED

SECTION PLAT

0			

330 Ft. from N. Line

_____ Ft. from S. Line

_____ Ft. from E. Line

990 Ft. from W. Line

Location _____

Rig up _____

Drilling and Remarks:

2000 oil-12 hrs2000 AcidPot-640

RECORD

Cased 7 in., 3001 ft.Sand 275, 3000

Gas _____

Oil _____

Total Depth 3050

PRODUCTION

1st 24 hrs. Nat. _____

1st 24 hrs. after shot _____

Gas _____ Cu. Ft.

Dry Hole _____

Abandoned _____

Date

JUL 14 1937

19

H. D. Hatfield

Scout