

SAS

Russell


FORM 51 5M PETROL

Section 20 Township 14 Range 14W

Well No. #6 Brandenburg

Company Texas

Hall-Gurney Pool NORTH

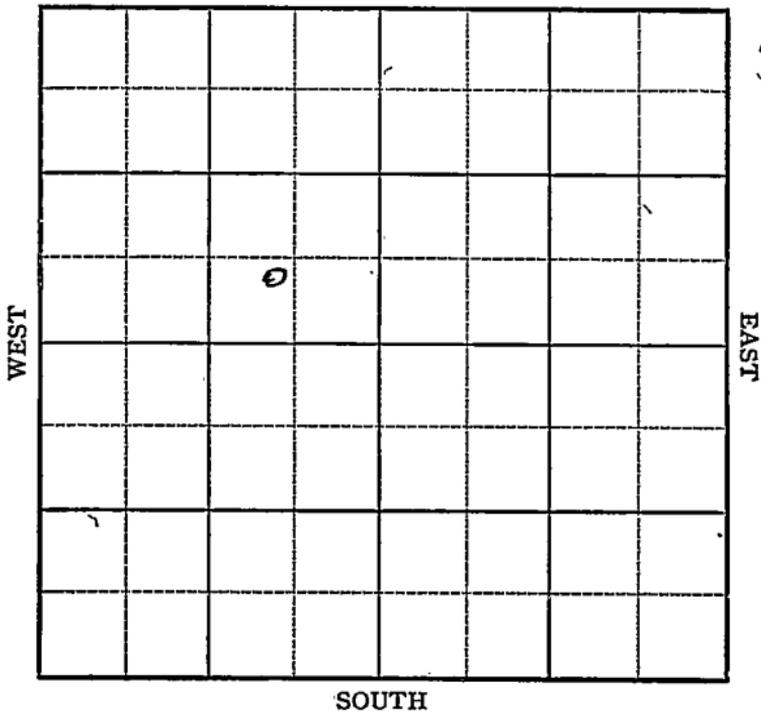

Sec. 20 Twp. 14 R. 14 W

Well No. #6 Brandenburg Farm


Texas Company

_____ Ft. from N. Line

610 Ft. from S. Line

810 Ft. from E. Line

_____ Ft. from W. Line

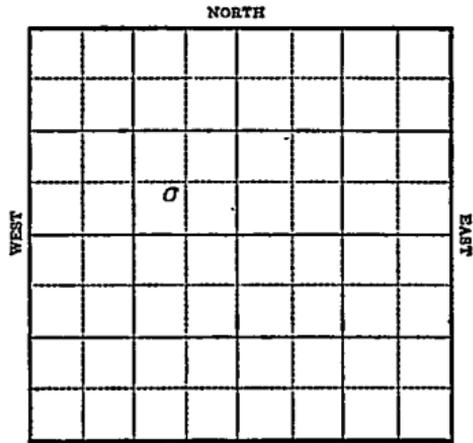

Elev. 1849

1943

R E P O R T

- 12-22 Rotary
- 12/29 "
- 1944
- 1-5 10" @ 358
Drlg 1545
- 1-12 Drlg 1894'
- 1/19 1894' Fsg.
- 1/26 Lans 2988
Drlg. 2996 SO
- 2/2 TD 3051'
7" @ 2990'
Rust
- 2/8 TD 3085-1500' oil
4000 acid.
- 2/16 7" @ 2990
Lans 2988
Lans 2988
TD 3085
4000 acid
Pump 431 Pot.
Gravity 38.3

COMPLETED

KANSAS
 Map No. 72 Sec. 20 Twp. 14 R. 14W

Well No. 6 Brandenburg

Texas Company

FIRST REPORT Contractor

C W L S E N W

SECTION PLAT

 Ft. from N. Line

610 Ft. from S. Line

810 Ft. from E. Line

 Ft. from W. Line

	o		

Hell-Gurney Pool

Location

Rig up

Drilling and Remarks:

Rotary

RECORD

Cased in., ft.

Sand

Gas

Oil

Total Depth

PRODUCTION

1st 24 hrs. Nat.

1st 24 hrs. after shot

Gas Cu. Ft.

Dry Hole

Abandoned

Date

DEC 22 1943 19

S. J. LEWIS Scout

KANSAS
 Map No. 72 Sec. 20 Twp. 14 R. 14W
 Well No. 6 Brandenburg

Texas Company

COMPLETED Contractor
C W L SE NW

SECTION PLAT

 Ft. from N. Line
610 Ft. from S. Line
810 Ft. from E. Line
 Ft. from W. Line

	o		

Williamson Pool

Location

Rig up

Drilling and Remarks:

*Lease 2988:
 7" @ 2990
 4000 acid
 Pump 431 BX
 35' - Ge*

RECORD

Cased in., ft.
 Sand
 Gas
 Oil
 Total Depth 2985

PRODUCTION

1st 24 hrs. Nat.
 1st 24 hrs. after shot
 Gas Cu. Ft.
 Dry Hole
 Abandoned

Date

FEB 16 1944 19

S. J. LEWIS Scout