


Form 51-5M 5-37 Petrol Russell

Section 20 Township 14 Range 14-W

Well No. 4 Brandenburg

Company Texas

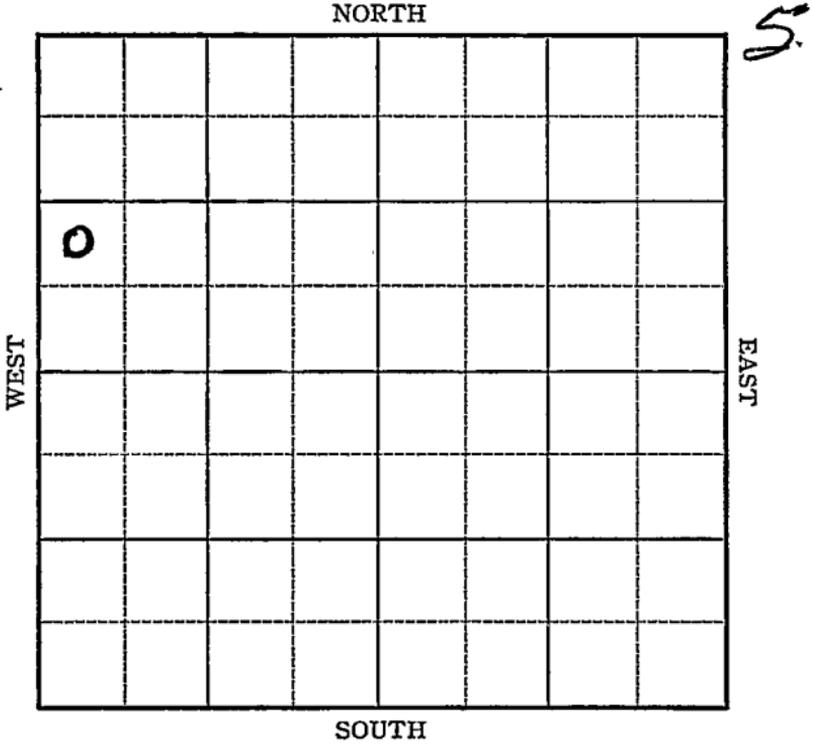

Sec. 20 Twp. 14 R. 14-W

Well No. #4 Brandenburg Farm

Texas Company


_____ Ft. from N. Line

990 Ft. from S. Line

_____ Ft. from E. Line

330 Ft. from W. Line

Elev. 1856

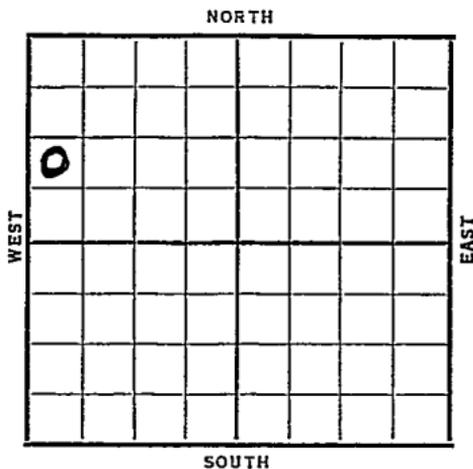

Date	REPORT
1937	
10/6	Cellar.
10/15	R. R.
10/22	11" @ 354'. Drlg. 1500'.
10/29	Drlg. 2915'.
11/5	K.C. 3012'. 7" @ 3013'.
	No shows reported. RUST.
11/10	7" @ 3013'.
	C.C. 3012'.
	T.D. 3031'.
	3000 acid.
	Potential 1764 bbls. flow.
	COMPLETED

Russell KANSAS

Map No. _____ Sec. 20 Twp. 14 R. 14W

Well No. 4 Brandenburg

Texas

Company _____

Contractor _____

FIRST REPORT

SECTION PLAT

NW SW NW

_____ Ft. from N. Line

990 Ft. from S. Line

_____ Ft. from E. Line

330 Ft. from W. Line

0			

Location _____

Rig up _____

Drilling and Remarks:

Cellar

RECORD

Cased _____ in., _____ ft.

Sand _____

Gas _____

Oil _____

Total Depth _____

PRODUCTION

1st 24 hrs. Nat. _____

1st 24 hrs. after shot _____

Gas _____ Cu. Ft.

Dry Hole _____

Abandoned _____

Date

OCT - 6 1937

19

H. D. Hatfield

Scout

Russell **KANSAS**

Map No. _____ Sec. 20 Twp. 14 R. 14W

Well No. 4 Brandenburg

_____ Texas _____ Company

_____ Contractor

COMPLETED

NW SW NW

_____ Ft. from N. Line

990 Ft. from S. Line

_____ Ft. from E. Line

330 Ft. from W. Line

SECTION PLAT

0			

Location _____

Rig up _____

Drilling and Remarks:

3000 acid

POT-1764

Flow

RECORD

Cased 7 in., 3013 ft.

Sand K.C. 3012

Gas _____

Oil _____

Total Depth 3031

PRODUCTION

1st 24 hrs. Nat. _____

1st 24 hrs. after shot _____

Gas _____ Cu. Ft.

Dry Hole _____

Abandoned _____

Date

NOV 10 1937 19

H. D. Hatfield Scout