


Section 20 Township 14 Range 14-W

Well No. #1 Crisman

Company Central Petroleum

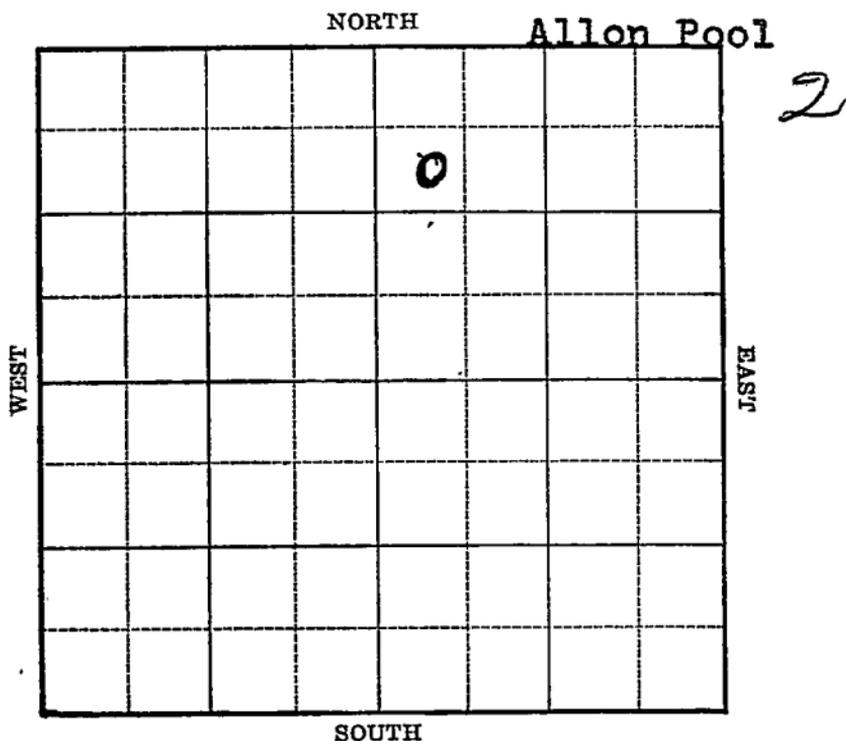

Sec. 20 Twp. 14 R. 14 -W

Well No. #1 Crisman Farm

Central Petr. Company


(Allon)

990 Ft. from N. Line

\_\_\_\_\_ Ft. from S. Line

\_\_\_\_\_ Ft. from E. Line

440 Ft. from W. Line

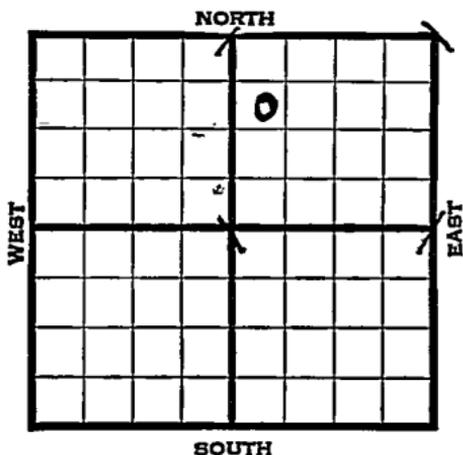

Elev. 1872

1939	REPORT
6/21	Location
6/29	Rigging up.
7/6	75½" - 375' Drlg. 465'
7/13	12" - 580' Anhy 863'
	10" - 874' Drlg. 1675'
7/20	8" - 2235' Drlg. 2425'
7/27	S. G. 2061-63' 8" - 2456'
	S.G. 2452-57' Drlg. 2565'
8/3	8" - 2519' Topeka 2723'
	Drlg. 2765'
8/9	6" - 2815' Drlg. 2870'
8/17	Dodge 3012' Lans. 3050'
	S.O. 3150-57' Cong. 3231'
	Drlg. 3289'
	OVER

1939

8/23

Granite 3320'

Dodge 3012'

Lans. 3050'

Cong. 3231-89'

T.D. 3335'

ABANDONED

Map No. \_\_\_\_\_ Sec. 20 Twp. 14 R. 14W

Well No. 1 Crisman

Central Petroleum Company

Contractor

**FIRST REPORT**

SW NW NE


**SECTION PLAT**

990 Ft. from N. Line

\_\_\_\_\_ Ft. from S. Line

\_\_\_\_\_ Ft. from E. Line

440 Ft. from W. Line

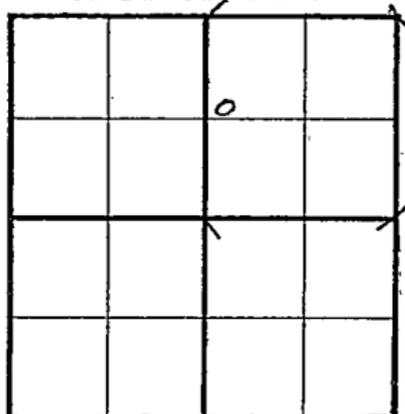

**ALLON POOL**

Location X

Rig up \_\_\_\_\_

Drilling and Remarks:

**RECORD**

Cased \_\_\_\_\_ in., \_\_\_\_\_ ft.

Sand \_\_\_\_\_

Gas \_\_\_\_\_

Oil \_\_\_\_\_

Total Depth \_\_\_\_\_

**PRODUCTION**

1st 24 hrs. Nat. \_\_\_\_\_

1st 24 hrs. after shot \_\_\_\_\_

Gas \_\_\_\_\_ Cu. Ft.

Dry Hole \_\_\_\_\_

Abandoned \_\_\_\_\_

Date

JUN 21 1939

19

S. J. LEWIS

Scout

Misc Small Maps .....  
Cards .....  
Tracing .....  
France Map .....  
Scarborough Map .....  
Moody Map .....  
Geological Dept. ....  
Moody Flat Book .....

*Ray*  
*Paul*  
*Joe*  
*Ray*

Map No. 72 Sec. 20 Twp. 14 R. 14W.

Well No. 1 Crisman

Central Petroleum Company

Contractor

SONORIVE

ABANDONED

990 Ft. from N. Line

\_\_\_\_\_ Ft. from S. Line

\_\_\_\_\_ Ft. from E. Line

440 Ft. from W. Line

SECTION PLAT

		o	

Allon Pool

Location \_\_\_\_\_

Rig up \_\_\_\_\_

Drilling and Remarks:

Granite 3320  
Dodge 3012  
Wane 3050  
Cong 3231-89

RECORD

Cased \_\_\_\_\_ in., \_\_\_\_\_ ft.

Sand \_\_\_\_\_

Gas \_\_\_\_\_

Oil \_\_\_\_\_

Total Depth 3335

PRODUCTION

1st 24 hrs. Nat. \_\_\_\_\_

1st 24 hrs. after shot \_\_\_\_\_

Gas \_\_\_\_\_ Cu. Ft.

Dry Hole \_\_\_\_\_

Abandoned: \_\_\_\_\_

Date

AUG 23 1939 19

S. J. LEWIS

Scout

Misc. Small Maps  
Cards  
Tracing  
France Map  
Scarborough Map  
Moody Map  
Geological Dept.  
Moody Flat Book

*RAY*  
*Ray*  
*Ray*