


Section 20 Township 14 Range 14W

Well No. #2, Miller

Company Sharon Drlg.

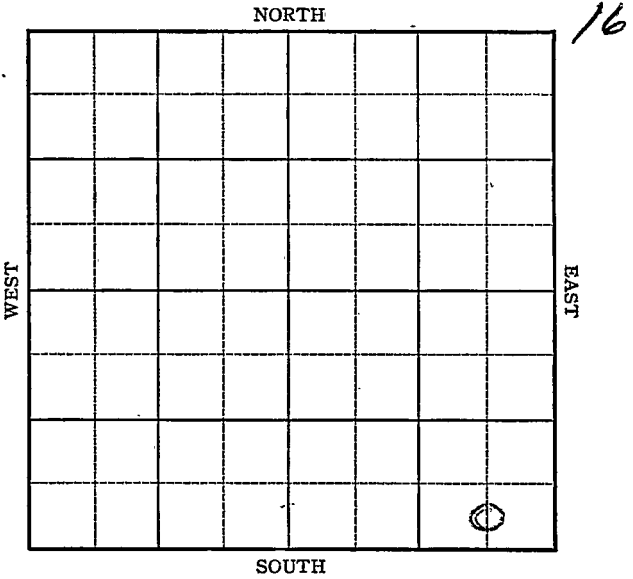

KANSAS

Russell County

Sec. 20 Twp. 14 R. 14W

Well No. #2 Miller Farm

Sharon Drlg. Company

Big Creek


_____ Ft. from N. Line

330 Ft. from S. Line

660 Ft. from E. Line

_____ Ft. from W. Line

CSL SE SE

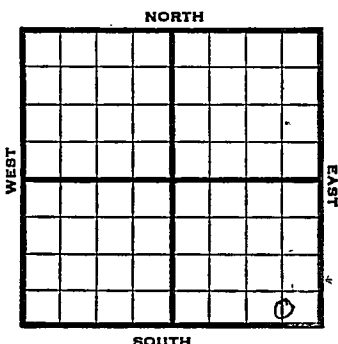

1946 Elev. 1845 REPORT

3/20 Location

4/4 8" @ 295
Anhy. 835
Lans. 3015
Drlg. 3041'

4/10 Arb. 3282
TD 3305

ABANDONED

KANSAS Kansas Pool Name Big Creek

Map No. 72 Sec. 20 Twp. 14 R. 14W

Well No. 2 Miller

Sharon Drlg. Company

ABANDONED Contractor

C S L SE SE

E 11845
SECTION PLAT

_____ Ft. from N. Line

330 Ft. from S. Line

660 Ft. from E. Line

_____ Ft. from W. Line

Russell County

Location _____

Rig up _____

Drilling and Remarks:

Cor 3282

RECORD

Cased _____ in., _____ ft.

Sand _____

Gas _____

Oil _____

Total Depth 3285

PRODUCTION

1st 24 hrs. Nat. _____

1st 24 hrs. after shot _____

Gas _____ Cu. Ft.

Dry Hole _____

Abandoned _____

Date

APR 10 1946 19

S. J. LEWIS Scout

KANSAS Kansas Pool Name Big Creek

Map No. 72 Sec. 20 Twp. 14 R. 14w

Well No. 2 Miller

Sharon Drlg. Company

FIRST REPORT

Contractor

C S L SE SE

SECTION PLAT

 Ft. from N. Line
330 Ft. from S. Line
660 Ft. from E. Line
 Ft. from W. Line

			o

Russell County

Location X

Rig up

Drilling and Remarks:

RECORD

Cased in., ft.
 Sand
 Gas
 Oil
 Total Depth

PRODUCTION

1st 24 hrs. Nat.
 1st 24 hrs. after shot
 Gas Cu. Ft.
 Dry Hole
 Abandoned

Date

MAR 20 1946 19

S. J. LEWIS Scout