

Russell


KANSAS

Form 51—5M—11-38—Palace

Section 20 Township 14 Range 14-W

Well No. #1 Miller "E"

Company Cities Service Oil

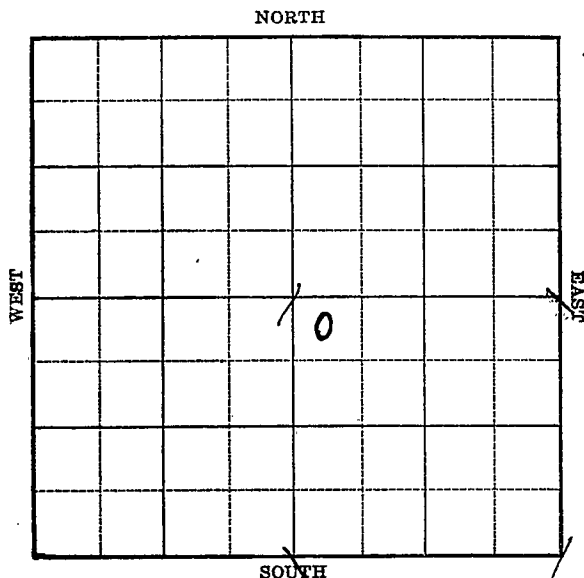


Map No. _____ Sec. 20 Twp. 14 R. 14WWell No. 1 Miller "E"

Cities Service Oil _____ Company

Contractor _____

FIRST REPORT

SECTION PLAT

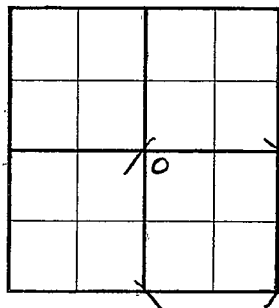330 NW SE
Ft. from N. Line

_____ Ft. from S. Line

_____ Ft. from E. Line

330 Ft. from W. Line

Location _____

Rig up _____

Drilling and Remarks:

BCR

RECORD

Cased _____ in., _____ ft.

Sand _____

Gas _____

Oil _____

Total Depth _____

PRODUCTION

1st 24 hrs. Nat. _____

1st 24 hrs. after shot _____

Gas _____ Cu. Ft.

Dry Hole _____

Abandoned _____

Date

DEC 13 1938

19

H. D. Hatfield Scout

Map No. 72 Sec. 20 Twp. 14 R. 14WWell No. 1 Miller "E"Cities Service Oil Company

Contractor

ABANDONED

NW SE

330 Ft. from N. Line

Ft. from S. Line

Ft. from E. Line

330 Ft. from W. Line

VAUGHN POOL

SECTION PLAT

		0	

Location

Rig up

Drilling and Remarks:

No oil

DFA

RECORD

Cased _____ in., _____ ft.

Sand Quartzite 3261

Gas _____

Oil _____

Total Depth 3283

PRODUCTION

1st 24 hrs. Nat. _____

1st 24 hrs. after shot _____

Gas _____ Cu. Ft.

Dry Hole _____

Abandoned _____

Date

JAN 4 - 1939 19

H. D. Hatfield Scout