

KANSAS


FORM 51 5M 6-46 PETROL

Ellis

Section 21 Township 17 Range 16ST

Well No. 1 Dreiling

Company Fred Manning

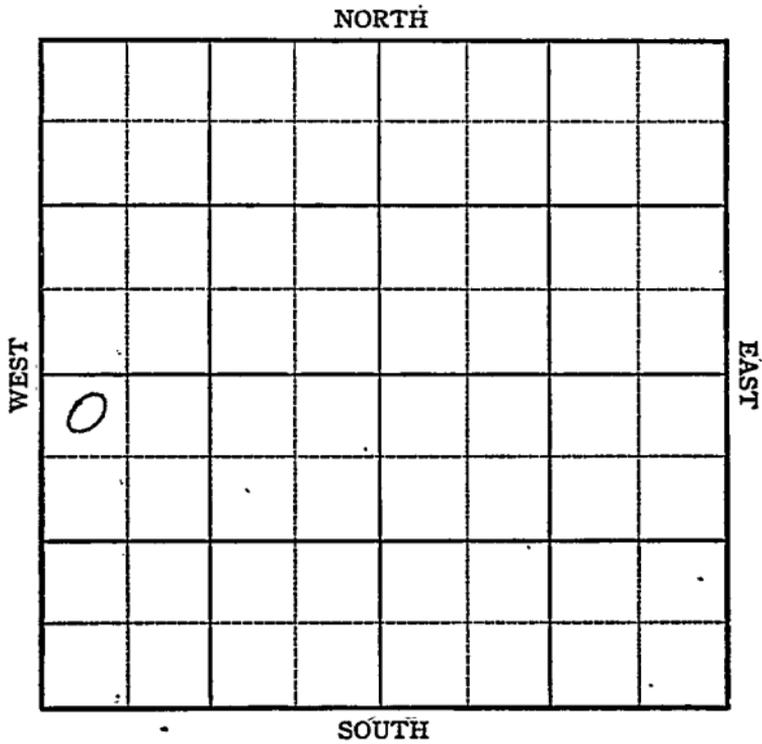

Sec. 21 Twp. 14 R. 16W

Well No. #1 Dreiling Farm

Fred Manning Company

Wildcat


330 Ft. from N. Line

_____ Ft. from S. Line

_____ Ft. from E. Line

330 Ft. from W. Line

NW SW

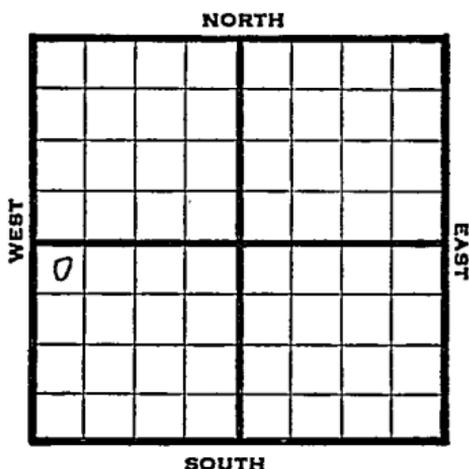

1946 Elev. 1879 REPORT

- 7/3 12" @ 57
Drlg. 659'
- 7/9 Anhy 1010
8" @ 1026
Drlg 2755'
- 7/17 Lans 3127
Arb. 3400
TD 3452'


ABANDONED

KANSAS

Kansas Pool Name WildcatMap No. 71 Sec. 21 Twp. 14 R. 16WWell No. 1 DreilingFred Manning Company**FIRST REPORT** Contractor

NW SW

SECTION PLAT

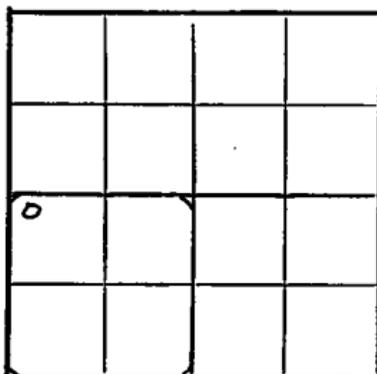330 Ft. from N. Line Ft. from S. Line Ft. from E. Line330 Ft. from W. LineEllis County

Location _____

Rig up _____

Drilling and Remarks:

12" @ 57'

659'

RECORD

Cased _____ in., _____ ft.

Sand _____

Gas _____

Oil _____

Total Depth _____

PRODUCTION

1st 24 hrs. Nat. _____

1st 24 hrs. after shot _____

Gas _____ Cu. Ft.

Dry Hole _____

Abandoned _____

Date

JUL 3 1946 19S. J. LEWIS Scout

KANSAS

Kansas

Pool Name Wildcat

Map No. 71 Sec. 21 Twp. 14 R. 16W

Well No. 1 Dreiling

Fred Manning Company

ABANDONED

Contractor

NW SW

E 1, 1879
SECTION PLAT

0			

330 Ft. from N. Line

 Ft. from S. Line

 Ft. from E. Line

330 Ft. from W. Line

Ellis County

Location

Rig up

Drilling and Remarks:

Love 8/27
Cr. 8.3400

RECORD

Cased in., ft.

Sand

Gas

Oil

Total Depth 3452

PRODUCTION

1st 24 hrs. Nat.

1st 24 hrs. after shot

Gas Cu. Ft.

Dry Hole

Abandoned

Date

JUL 17 1946 19

S. J. LEWIS Scout