


KANSAS Ellis

FORM 51 5M PETROL

Section 21 Township 14 Range 16-W

Well No. #1 Dreiling

Company Fred Manning

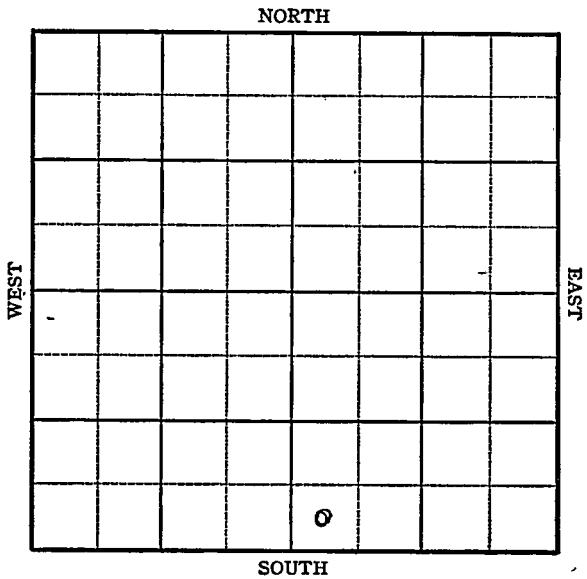

Sec. 21 Twp. 14 R. 16-W

Well No. #1 Dreiling Farm


~~D. G. Gordon~~ Fred Manning Company

 Ft. from N. Line

330 Ft. from S. Line

 Ft. from E. Line

330 Ft. from W. Line

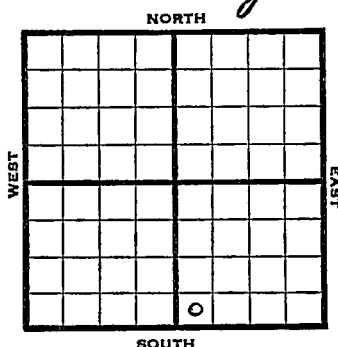

SW SE

1945 Elev. 1884' REPORT

12/5 Location

12/12 13" @ 47
Drlg. 1576

12/20 Drlg. 3000'

12/29 Lans 3136' Cong 3377'
5" - 3380' Arb. 3380-88' T.D.
RUST.

1946

1/9 Arb. 3380
5" @ 3380
TD 3448'

ABANDONED

KANSAS

Kansas


Pool Name WildcatMap No. 71Sec. 21Twp. 14R. 16WWell No. 1 DreilingFred Manning

Company

ABANDONED

Contractor

SW SE

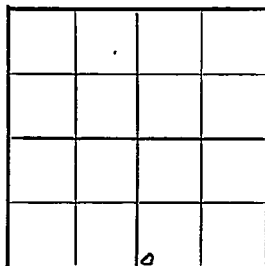E. 1884
SECTION PLAT

Ft. from N. Line

330

Ft. from S. Line

Ft. from E. Line

330

Ft. from W. Line

Ellis County

Location

Rig up

Drilling and Remarks:

Cur 3350
5 @ 3350*

RECORD

Cased _____ in., _____ ft.

Sand _____

Gas _____

Oil _____

Total Depth 3448

PRODUCTION

1st 24 hrs. Nat. _____

1st 24 hrs. after shot _____

Gas _____ Cu. Ft.

Dry Hole _____

Abandoned _____

Date

JAN 9 1946 19

S. J. LEWIS

Scout

KANSAS Kansas Pool Name Wil catMap No. X-7/ Sec. 21 Twp. 14 R. 16WWell No. 1 DreilingFred Manning

Company

CORRECTION

Contractor

SW SE

SECTION PLAT

Ft. from N. Line330Ft. from S. LineFt. from E. Line330Ft. from W. LineEllis County

Location

Rig up

Drilling and Remarks:

report D. G. Gordon

*Corrected
Co name*

RECORD

Cased in, ft.Sand Gas Oil Total Depth

PRODUCTION

1st 24 hrs. Nat. 1st 24 hrs. after shot Gas Cu. Ft.Dry Hole Abandoned

Date

DEC 12 1945 19

S. J. LEWIS Scout


KANSAS Pool Name WildcatMap No. 15-71 Sec. 21 Twp. 14 R. 16WWell No. 1 DreilingD. G. Gordon Company

FIRST REPORT

Contractor

SW SE

SECTION PLAT

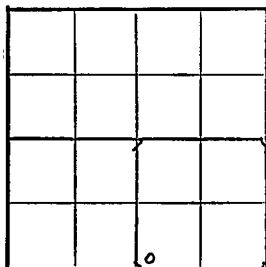 Ft. from N. Line330 Ft. from S. Line Ft. from E. Line330 Ft. from W. LineEllis CountyLocation XRig up

Drilling and Remarks:

RECORD

Cased in., ft.Sand Gas Oil Total Depth

PRODUCTION

1st 24 hrs. Nat. 1st 24 hrs. after shot Gas Cu. Ft.Dry Hole Abandoned

Date

DEC 5 1945 19S. J. LEWIS Scout