

Section 21 Township 14 Range 16WWell No. #1 DreilingCompany Courtney Davis

NORTH

							0

WEST

EAST

SOUTH


Sec. 21 Twp. 14 R. 16WWell No. #1 Dreiling FarmCourtney Davis CompanyLewis Contractor
Dreiling

Ft. from N. Line

330 Ft. from S. Line330 Ft. from E. Line

Ft. from W. Line

SE SE SE

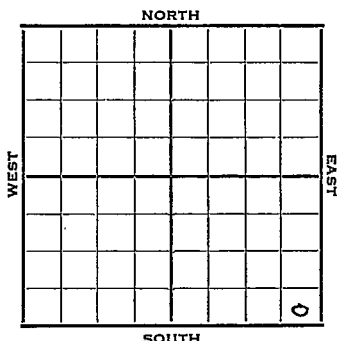

1952	Elev. 1854'	REPORT
5/14	Spud 5-5-52 8" @ 666 Anhy 955' Drlg. 2942'	
5/21	Heeb 3059' Tor. 3078' Lans. 3106' DST 3108-40, 1 hr, 22' M SSO DST 3226-55, 1/2 hr, 60' HOCM, 150' MCO, 400# Arb. 3349' RTD 3353' 5" @ 3350'	
5/28	32/ 3244-52 S/ 2 Boph 2000 A S/ 10 Boph for 5 hrs. POP	
6/11	P/4 BOPH plus trace wtr.	
6/18	NR	
6/25	NR	
7/2	"	
7/9	Spud 5-5-52 Oil well TD 3353' 8" @ 666 Anhy 955' Heeb 3059' Tor. 3078' Lans. 3106' DST 3108-40 open 1 hr. rec 22' mud & SSO DST 3226-55 open 1/2 hr. rec 60' HOCM 150' MCO Arb. 3349' TD 3353' 5" @ 3350' 32/3244-52 S/2 BOPH 2000 A S/10 BOPH 5 hr. Comp. 28 BOPD 3% water	
COMPLETED		

J. G. McGEHEE