





Ellis County Kansas State

Map No. Sec. 21 Twp. 14 R. 16W

Well No. 1 Dreiling

M. B. Armer Company

Contractor

SE NE


FIRST REPORT SECTION PLAT

Ft. from N. Line

330 Ft. from S. Line

330 Ft. from E. Line


Ft. from W. Line

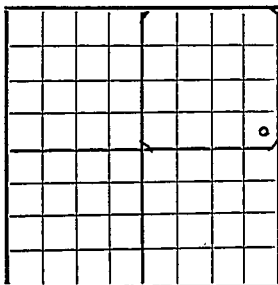

Wildcat

Remarks:

Location

 

Date JUN 8 1949

Scout S. J. LEWIS

Kansas

Map No. K71 Sec. 21 Twp. 14 R. 16W

Well No. 1 Dreiling

M. B. Armer Company

**COMPLETE**

Contractor

SE NE

E11862  
**SECTION PLAT**


\_\_\_\_\_ Ft. from N. Line

330 Ft. from S. Line

330 Ft. from E. Line

\_\_\_\_\_ Ft. from W. Line

Ellis County

**RECORD**

Location \_\_\_\_\_

Cased \_\_\_\_\_ in., \_\_\_\_\_ ft.

Rig up \_\_\_\_\_

Sand \_\_\_\_\_

Drilling and Remarks:

Gas \_\_\_\_\_

Oil \_\_\_\_\_

Total Depth 3383

Cr & 3366  
5" @ 3367  
500 acid  
Prod 173 oil 8/24  
33 5/8 in

**PRODUCTION**

1st 24 hrs. Nat. \_\_\_\_\_

1st 24 hrs. after shot \_\_\_\_\_

Gas \_\_\_\_\_ Cu. Ft.

Dry Hole \_\_\_\_\_

Abandoned \_\_\_\_\_

Date

AUG 10 1949 19

S. J. LEWIS Scout