

Russell

KANSAS

SEC. 21

TWP. 14

R. 11W

WELL NO.

#5 Boxberger "SWB"

FARM

COMPANY

Duke Drlg.

CONTRACTOR

Co.

Hall-Gurney

_____ FT. FROM N. LINE


_____ FT. FROM S. LINE

_____ FT. FROM E. LINE

_____ FT. FROM W. LINE

SW SW NE

(Twin to abdn. well)

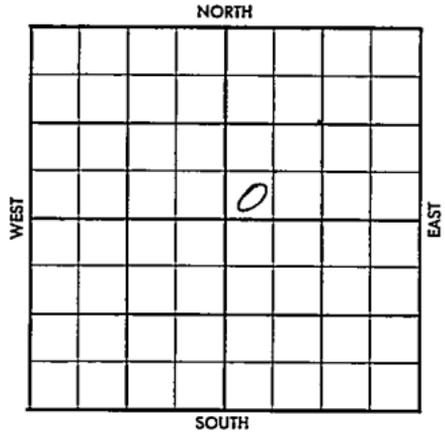

1956

ELEVATION
1855 DF

REPORT

8-29

Comm. 8-21-56
8" @ 506 w/275
Anh. 860'; Grd. Haven Ls. 2388';

County Russell Elev. 1855 DF
 Sec. 21 Twp. 11S Rge. 11W
 Company Duke Drilling
 FarmName Boxberger "SWD" No. 5

TOPS	DEPTH	LOG	DATUM
Anh.	060		
TP			
Grd. Haven	Ls. 2388		
Tr.			
Dg.			
Bl.			
L.			
K.C.			
B.K.C.			
Ce.			
C.			
M.			
M.			
K.			
Mz.			
Mo.			
V.			
S.			
S.			
A.			
R.			
PE.			
G.			
T.D.			

Loc. in Sec. SW SW NE
 Geol. _____
 Contr. Co.
 Pool Hall
Gurney

AUG 29	'56
	0

 FIRST REPORT

Date Comm. 8-21-56 Twin to abdn. well
8th 506 w/275

289 2 1932

Co.
 Lse.
 No.
 Sec.
 T.
 R.

County Russell Elev. 1855 DF
 Sec. 21 Twp. 14S Rge. 14W
 Company Duke Drilling
 Farm Name Boxberger No. 5

TOPS	DEPTH	LOG	DATUM	Loc. in Sec.
	000			SW SW NE
Grd. Haven Is.	2388			
Tc. 1st Tank	2400			
Dg. Day LI	2413			
Bl. 2nd Tank	2422			
L. Tank LI	2460			Geol. _____
K.C. H6	2952			Cont. Co. _____
B.K.C. Tr	2971			
Ce. L59	3012			
C.				
M.				
M.				Pool Hall
K.				Gurney
Mz.				
Ma.				
V.				
S.				
S.				
A.				
R.				
PE.				
G.				
TD.	3022			

COMPLETE
 0
 SEP 19 '56

Date Comm. 8-21-56 Twin to abdn. well
 8" 506 w/275 SEP 5 '56 5 1/2 3014 / SEP 12 '56
 CO 3022 B 15 Goph +
 wtr to DD SEP 19 '56 DD 3114
 8 1/2" Liner to 3111 2" Tbg
 to 3111 16 POP. P. 25
 B0 + 85% wtr 24 hrs
 est P. 20 BOPD + 75%
 wtr.