

KANSAS

Russell

Form 51-5M-7-40-Palace

Section 21 Township 14 Range 14-W

Well No. #8 Boxberger

Company Helmerich & Payne

NORTH Hall-Gurney Pool

					0		/

WEST

EAST


SOUTH

Sec. 21 Twp. 14 R. 14 WWell No. #8 Boxberger FarmHelmerich & Payne Company

(Hall-Gurney)

330 Ft. from N. Line Ft. from S. Line1320 Ft. from E. Line Ft. from W. Line

Elev. 1890

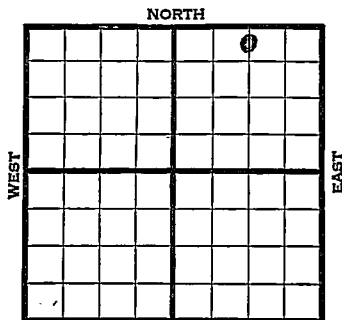

1941	REPORT
3/5	Cellar.
3/13	8" - 325' Drlg. 1540'
3/20	Lans. 3012' 5" - 3045'
	T.D. 3048' RUST.
3/27	" " "
4/2	" " "
4/10	" " "
4/18	" " "
4/24	" " "
5/1	T.D. 3124' 6000 acid.
	Shut down.
5/8	" "
5/15	" "
5/22	" "
5/28	" "
6/5	" "
	OVER

1941

6/11

Lans. 3012'

5" - 3045'

T.D. 3124'

6000 acid.


Potential 226 bbls., pump.

38. Gravity

COMPLETED

Map No. 72 Sec. 21 Twp. 14 R. 14WWell No. 8 BoxbergerHelmerich & Payne CompanyFIRST REPORT Contractor

SECTION PLAT

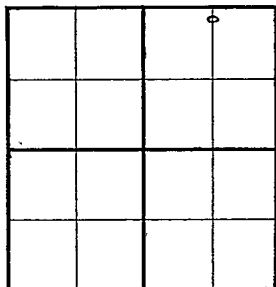

C N I L N E

330 Ft. from N. Line Ft. from S. Line1320 Ft. from E. Line Ft. from W. Line

HALL-GURNEY POOL

Location Rig up

Drilling and Remarks:

Cellar

RECORD

Cased in., ft.Sand Gas Oil Total Depth

PRODUCTION

1st 24 hrs. Nat. 1st 24 hrs. after shot Gas Cu. Ft.Dry Hole Abandoned

Date

MAR 5 1941 19 S. J. LEWIS Scout

RAM

Misc. Small Maps *RAM*

Cards *RAM*

Tracing *JMS*

Front Map *RAM*

Geological Map *JMS*

Moody Map *JMS*

Geological Dept.

Moody Flat Book

Map No. 72 Sec. 21 Twp. 14 R. 14WWell No. 8 BoxbergerHelmerich & Payne CompanyCOMPLETED Contractor

C N L N E

SECTION PLAT

			0

330 Ft. from N. Line Ft. from S. Line1320 Ft. from E. Line Ft. from W. Line

HALL GURNEY POOL

Location Rig up

Drilling and Remarks:

*Liams. 3012.**5" @ 3045**6000 acud**Pump 226 Ps**35° G*

RECORD

Cased in., ft.Sand Gas Oil Total Depth 3124

PRODUCTION

1st 24 hrs. Nat. 1st 24 hrs. after shot Gas Cu. Ft.Dry Hole Abandoned

Date

JUN 11 1941 19S. J. LEWIS Scout

Misc. Small Maps

Cards

Tracing

France Map

Scarborough Map

Moody Map

Geological Dept.

Moody Flat Book