

# KANSAS

Form 51-5M-7-39-Palace

Russell


Section 21 Township 14 Range 14-W

Well No. #4 Boxberger

Company Helmerich & Payne

Gurney Pool

NORTH

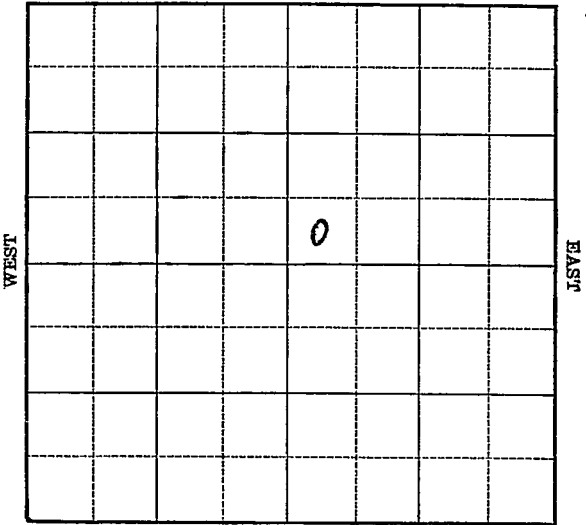

SOUTH

# KANSAS Russell

FORM 252-A 5M 2-40

Sec. 21 Twp. 14 R. 14-W

Well No. #4 Boxberger Farm

Helmerich & Payne Company

(Gurney)


\_\_\_\_\_ Ft. from N. Line

330 Ft. from S. Line

\_\_\_\_\_ Ft. from E. Line

330 Ft. from W. Line

**Elev. 1853**

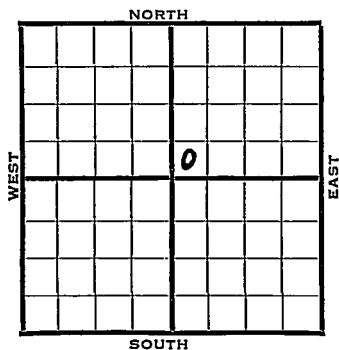

	REPORT
1940	
6/26	Derrick.
7/3	"
7/11	"
7/18	"
7/25	"
8/2	"
8/8	"
8/14	"
8/22	"
8/29	"
9/5	"
9/12	8" - 371' Anhy 840' Drlg. 2260'
9/19	Lans. 3003' 5" - 3003' Drlg. 3015' No shows.
9/26	T.D. 3111' 7000 acid.
10/3	Shut down.
10/10	" "
	<b>OVER</b>

1940

10/16 Lans. 3003'

5" - 3003'

T.D. 3111'

7000 acid.

Potential 2625 bbls., pump.

COMPLETED



Misc. Small Maps..... *BAW*  
Cards..... *BAW*  
Tracing..... *BAW*  
France Map..... *BAW*  
Scarborough Map..... *BAW*  
Moody Map..... *BAW*  
Geological Dept. ....  
Moody Plat Book .....

Map No. 72 Sec. 21 Twp. 14 R. 14W

Well No. 4 Boxberger

Helmerich & Payne Company

Contractor

**COMPLETED**

SW NE

\_\_\_\_\_ Ft. from N. Line

330 Ft. from S. Line

\_\_\_\_\_ Ft. from E. Line

330 Ft. from W. Line

**SECTION PLAT**

		o	

GURNEY POOL

Location \_\_\_\_\_

Rig up \_\_\_\_\_

Drilling and Remarks:

*lane 3003*  
*5" C 3003*  
*7000 acid*  
*Pump 2625 P.X.*

**RECORD**

Cased \_\_\_\_\_ in., \_\_\_\_\_ ft.

Sand \_\_\_\_\_

Gas \_\_\_\_\_

Oil \_\_\_\_\_

Total Depth 3111

**PRODUCTION**

1st 24 hrs. Nat. \_\_\_\_\_

1st 24 hrs. after shot \_\_\_\_\_

Gas \_\_\_\_\_ Cu. Ft.

Dry Hole \_\_\_\_\_

Abandoned \_\_\_\_\_

Date

OCT 16 1940 19

S. J. LEWIS Scout

