

# KANSAS

Form 51-5M-7-40-Palace


Russell

Section 21 Township 14 Range 14-W

Well No. #3 Holl

Company Alva Billings

NORTH Gurney Pool

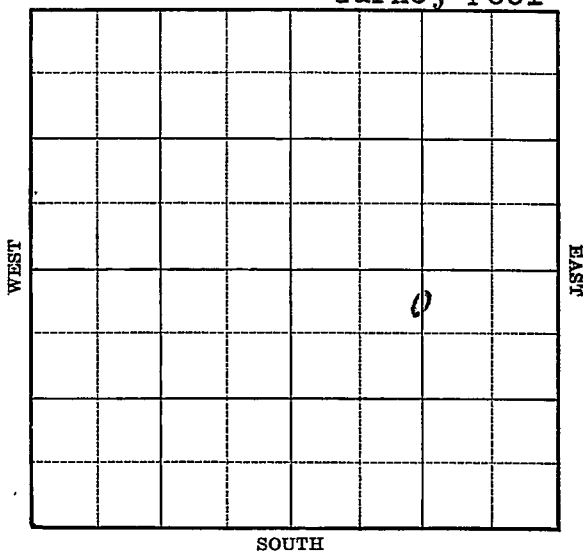



1940  
12/11

Lans. 3000'

7" - 3005'

T.D. 3105'

3400 acid.

Potential 2702 bbls., pump & flow

38. Gravity

**COMPLETED**

Map No. 72 Sec. 21 Twp. 14 R. 14W

Well No. 3 Holl

Alva Billings Company

Contractor

**FIRST REPORT**

C N L SE

330 Ft. from N. Line

\_\_\_\_\_ Ft. from S. Line

1320 Ft. from E. Line

\_\_\_\_\_ Ft. from W. Line

**SECTION PLAT**

		⊙	

**GURNEY POOL**

Location \_\_\_\_\_

Rig up \_\_\_\_\_

Drilling and Remarks:  
**Cable**

**RECORD**

Cased \_\_\_\_\_ in., \_\_\_\_\_ ft.

Sand \_\_\_\_\_

Gas \_\_\_\_\_

Oil \_\_\_\_\_

Total Depth \_\_\_\_\_

**PRODUCTION**

1st 24 hrs. Nat. \_\_\_\_\_

1st 24 hrs. after shot \_\_\_\_\_

Gas \_\_\_\_\_ Cu. Ft.

Dry Hole \_\_\_\_\_

Abandoned \_\_\_\_\_

Date

AUG 21 1949

S. J. LEWIS

Scout

Misc Small Maps .....  
Cards .....  
Tracing .....  
France Map .....  
Scarborough Map .....  
Moody Map .....  
Geological Dept. ....  
Moody Flat Book .....

*Handwritten signatures and initials:*  
- Large signature over "Misc Small Maps"  
- Signature over "Cards"  
- Initials "JMB" over "Tracing"  
- Large signature over "France Map"  
- Large signature over "Scarborough Map"  
- Initials "JMB" over "Moody Map"

Map No. 72 Sec. 21 Twp. 14 R. 14W

Well No. 3 Holl

Alva Billings Company

Contractor

**COMPLETED**  
C N L SE

**SECTION PLAT**


330 Ft. from N. Line

\_\_\_\_\_ Ft. from S. Line

1320 Ft. from E. Line

\_\_\_\_\_ Ft. from W. Line

GURNEY POOL

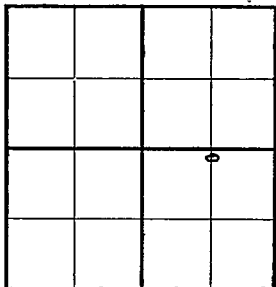

Location \_\_\_\_\_

Rig up \_\_\_\_\_

Drilling and Remarks:

*Wane 3000*  
*7" @ 3005*  
*3400 Acid*  
*P. & F 2702 P & S*  
  
*38° SW*

**RECORD**

Cased \_\_\_\_\_ in., \_\_\_\_\_ ft.

Sand \_\_\_\_\_

Gas \_\_\_\_\_

Oil \_\_\_\_\_

Total Depth 3105.

**PRODUCTION**

1st 24 hrs. Nat. \_\_\_\_\_

1st 24 hrs. after shot \_\_\_\_\_

Gas \_\_\_\_\_ Cu. Ft.

Dry Hole \_\_\_\_\_

Abandoned \_\_\_\_\_

Date

DEC 11 1940 19

S. J. LEWIS Scout

Misc. Small Maps..... *RMJ*  
Cards..... *RMJ*  
Tracing..... *JMB*  
France Map..... *RMJ*  
Scarborough Map..... *RMJ*  
Moody Map..... *JMB*  
Geological Dept. ....  
Moody Flat Book .....