

KANSAS

Form 51-5M-7-40-Palace

Russell

Section 21 Township 14 Range 14-W

Well No. 2 Holl

Company National Refining

NORTH Hall Gurney Lansing

16'

WEST

EAST

0

SOUTH

Sec. 21 Twp. 14 R. 14-W

Well No. #2 Holl Farm _____

National Refining Company

(Hall-Gurney-Lansing)


_____ Ft. from N. Line

990 Ft. from S. Line

330 Ft. from E. Line

_____ Ft. from W. Line

Elev. 1830

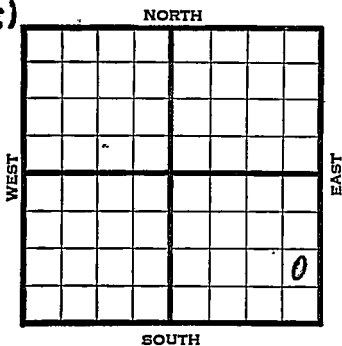

1941	REPORT
1/8	Location
1/16	"
1/23	R.U.R.
1/30	Anhy 809' 10" - 825'
	Drlg. 1000'
2/6	Drlg. 2900'
2/13	Lans. 2980' 7" - 3003'
	T.D. 3040' Fsg.
2/19	Lans. 2980'
	7" - 3003'
	T.D. 3076'
	7000 acid.
	Potential 2819 bbls., pump & flow. 38. Gravity
	COMPLETED

Map No. 72 Sec. 21 Twp. 14 R. 14W

Well No. 2 Holl

National Refining

Company

Contractor

FIRST REPORT

SECTION PLAT

NE SE SE

			o

_____ Ft. from N. Line

990 Ft. from S. Line

330 Ft. from E. Line

_____ Ft. from W. Line

HALL GURNEY LANSING

Location X

Rig up _____

Drilling and Remarks:

RECORD

Cased _____ in., _____ ft.

Sand _____

Gas _____

Oil _____

Total Depth _____

PRODUCTION

1st 24 hrs. Nat. _____

1st 24 hrs. after shot _____

Gas _____ Cu. Ft.

Dry Hole _____

Abandoned _____

Date

JAN 8 1941 19

S. J. LEWIS Scout

Map No. _____ Sec. 21 Twp. 14 R. 14W

Well No. 2 Holl

National Refining Company

Contractor

COMPLETED

SECTION PLAT

NE SE SE

			o

_____ Ft. from N. Line

990 Ft. from S. Line

330 Ft. from E. Line

_____ Ft. from W. Line

HALL-GURNEY LANS.
Pool

Location _____

Rig up _____

Drilling and Remarks:

Lane 2980
7" C8003
9000 acid
P.Y.# 2819 BX

380 Gr

RECORD

Cased _____ in., _____ ft.

Sand _____

Gas _____

Oil _____

Total Depth 3076

PRODUCTION

1st 24 hrs.-Nat. _____

1st 24 hrs. after shot _____

Gas _____ Cu. Ft.

Dry Hole _____

Abandoned _____

Date

FEB 19 1941 19

S. I. LEWIS Scout