Russell


FORM 51

KANSAS

Section 21 Township 14 Range 14W

Well No. #1 Holl

Company United Drlg.

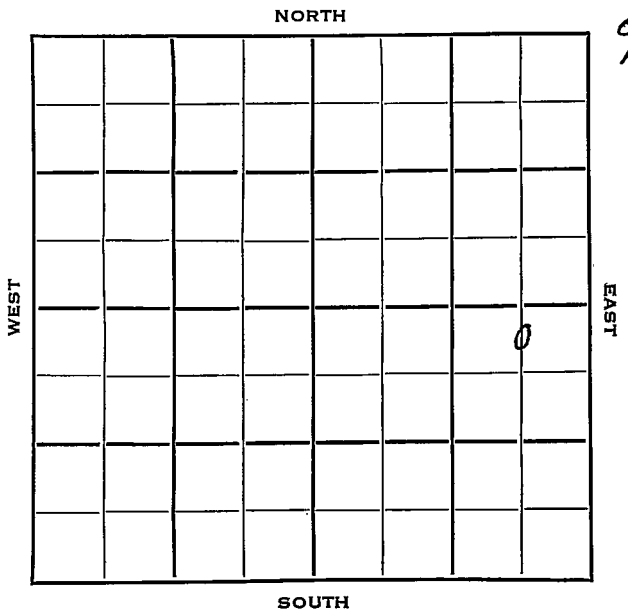

Russell KANSAS

SEC.	TWP.	R.
21	14	14 W

WELL NO.

1 Holl FARM
COMPANY

United Drlg.
CONTRACTOR

United Drlg.

Hall-Gurney Pool


330 Ft. from N. Line

Ft. from S. Line

660 Ft. from E. Line

Ft. from W. Line

C N L NE SE

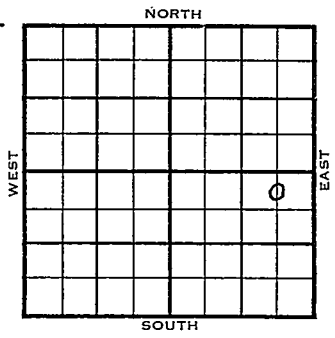

	ELEVATION	REPORT
1954	1833'	
1/27		Spud 1-22-54 8" @ 163 Anhy 830' Drlg. 2259'
2/3		Gd Haven 2358', 2nd Tarkio 2390' RTD 2430 5" @ 2430'
2/10		NR
2/17		"
2/24		"
3/17		Spud 1-22-54 Oil Well TD 2430' 8" @ 163' Anhy 830', Gr. Haven 2358', 2nd Tarkio 2390' TD 2430' 5" @ 2430' 33/2389-93 FU 1000' oil 12 hrs. Sd-oil-frac P/2½ boph 5% wtr. Cpmp. 25 bopd

COMPLETED

DX-78

FORM 275 FOR SALE BY KANSAS BLUE PRINT CO.


County Russell State Kansas

Sec. 21 (Blk. Twp.) 14 (Sur. Rge.) 14W Map No.

Operator United Drlg.

Well No. 1 Farm Holl

Elev. 1883 Location C N L NE SE

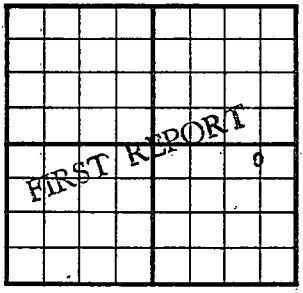

330 Ft. From N Line SE

660 Ft. From E Line Quarter

1st. Report JAN ? 7 1954

Completion

Remarks

United Drlg. - Contr.

Spudding Date 1-22-54

Drlg. Data Hall-Gurney Pool

8" @ 163 Anhy 830 drlg. 2259

J. G. McGEHEE

FORM 275 FOR SALE BY KANSAS BLUE PRINT CO.


County Russell State Kansas

Sec. 21 (Blk. Twp.) 14 (Sur. Rge.) 14W Map No.

Operator United Drlg.

Well No. 1 Farm Holl

Elev. 1833 Location C N L NE SE

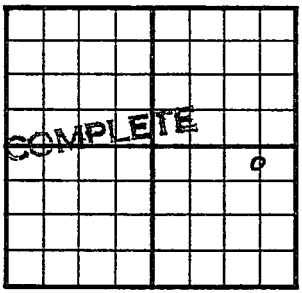

330 Ft. From N Line SE

660 Ft. From E Line Quarter

1st. Report

Completion MAR 17 1954

Remarks Hall-Garney Pool

United Drlg. - Contr.

Spudding Date 1-22-54

Drlg. Data Oil well TD 2430

8" @ 163 Anhy 830 Gr. Haven 2358

2nd Tarkio 2390 TD 2430 5" @ 2430

33/ 2389-93 FU 1000' oil 12 hr.

sd-oil-frac P/ 2½ boph 5% wtr.

Comp. 25 bopd

J. G. McGEHEE